

Holmes  
M10  
log #82  
12-93-73

MISSISSIPPI  
BOARD OF WATER COMMISSIONERS  
416 North State Street  
Jackson, Mississippi 39201

CODED

WATER WELL DRILLERS LOG

12-13-73 1973 JETCOH Drilling Co Holmes  
date well completed firm name county well located


LANDOWNER: M. Patrick Brown  
Dexington, MS.  
(mailing address)

WELL LOCATION:  
sec. 13 T. 15 N. R. 3 E  
7.2 miles NE of Dexington  
(distance) (direction) (nearest town)

WELL PURPOSE:  
(home, irrigation, municipal, industrial)

WELL COMPLETION DATA:  
(1) diameter (inches) 4 X 2  
(2) total depth (feet) 628  
(3) static water level (feet) 48 ft below top of ground.  
(4) casing Steel 592 ft.  
(material) (depth)  
(size) if telescope see back.  
(5) screen 30 ft. 60  
(length) (depth to top)  
2 lines Stainless Steel  
(size) (material)  
(6) pump 1/2 HP. 203 gpm  
(HP) (yield gpm)  
Electric  
(type power)  
(7) electric log (yes or no)  
MS. Geological Survey  
(organization running log)  
(8) how well bottom plugged 1/8 steel  
rod

description of formations encountered	from	to
SAND	0	60
SHALE	60	130
SAND	130	150
SHALE	150	236
SAND WITH SHALE BIRTS	236	350
SHALE	350	470
SAND WITH SHALE BIRTS	470	540
SHALE	540	575
SAND	575	628

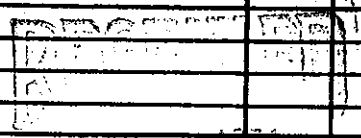

MAR 18 1974

DRILLERS REMARKS: