

Holmes
 Mill
 10/74

MISSISSIPPI BOARD OF WATER COMMISSIONERS

WATER WELL DRILLERS LOG

Date: Oct, 19, Driller: Jack Martin County Holmes

(1) Owner of Land:	Description & Color of Materials Sand, Clay, Red Clay, Shell, etc.	Thick- ness Feet	Depth Feet
Dee Dee plantation (Name) Schlatter (Address)	Clay		2.2
(2) Location: NW 1/4, 1/4, Sec. 5 T15 R3E	Sand & g		33
6 miles N of Lexington (distance) (direction) (Nearest Town)	Sand little p.c.		48
(3) Topography: Hilly (Hilly) (Flat) (Level)	Sand		103
(4) Purpose of Well: Domestic (Domestic Irrigation Municipal, Industrial, Other)			

Information upon completion of well:

- (1) Diameter 4 inches.
- (2) Total Depth 103 feet.
- (3) Water Level 67 feet below top of ground.
- (4) Cased to 13, Size 4
- (5) Screen: Size 4", Length 30
- (6) Were any formations sealed against pollution?
 yes, no.

If YES depth of formation _____


Why _____

Drillers Remarks: _____

Yield in gpm: 10

Size pump: 3/4 HP

Type power: Electric

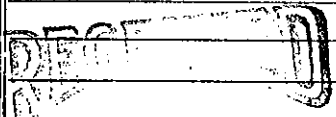

NOV - 1 1974

MISS. BD. OF WATER COMM

Mail this copy to Board of Water Commissioners 429 Miss. St. Jackson, Miss.