

HOLMES MISSISSIPPI BOARD OF WATER COMMISSIONERS

M12  
7-62

WATER WELL DRILLERS LOG

CODED

Date: July, 1962, Driller: Jack Martin County Noleno  
(Name)

(1) Owner of Land:	Description & Color of Materials Sand, Clay, Red Clay, Shell, etc.	Thick- ness Feet	Depth Feet
<u>Ernest Harrison</u> (Name) <u>Lexington</u> (Address)	<u>Top clay</u>	<u>3</u>	<u>3</u>
	<u>Sand</u>	<u>4</u>	<u>7</u>
(2) Location: <u>SW 1/4, SE 1/4, Sec. 33 T12R3E</u> <u>3</u> miles <u>East</u> of <u>Lexington</u> (distance) (direction) (Nearest Town)	<u>Pipe Clay</u>	<u>5</u>	<u>12</u>
	<u>Sand</u>	<u>24</u>	<u>36</u>
	<u>Mud</u>	<u>40</u>	<u>76</u>
	<u>Sand</u>	<u>13</u>	<u>89</u>
(3) Topography: <u>Hilly</u> (Hilly) (Flat) (Level)	CODED		
(4) Purpose of Well: <u>Domestic</u> (Domestic Irrigation Municipal, Industrial, Other)			


Information upon completion of well:

- (1) Diameter 2 inches.
- (2) Total Depth 88 feet.
- (3) Water Level 25 feet below top of ground.
- (4) Cased to 83, Size 2"
- (5) Screen: Size 2", Length 5'
- (6) Were any formations sealed against pollution?  
\_\_\_\_\_ yes, \_\_\_\_\_ no.

If YES depth of formation \_\_\_\_\_

Why \_\_\_\_\_

Drillers Remarks: \_\_\_\_\_

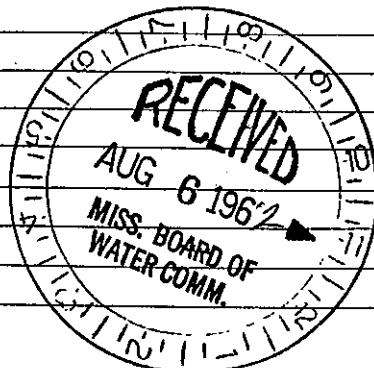

(Use Back Side)

Well No

Mail this copy to Board of Water Commissioners 429 Miss. St. Jackson.