

HOLMES
M 15

MISSISSIPPI BOARD OF WATER COMMISSIONERS

WATER WELL DRILLERS LOG

CODED

7-64
Date: July, 1964, Driller: Jack Martin County Holmes
(Name)

(1) Owner of Land:	Description & Color of Materials Sand, Clay, Red Clay, Shell, etc.	Thick- ness Feet	Depth Feet
<u>A.L. Jenkins</u> (Name)	<u>clay</u>	<u>8</u>	<u>8</u>
<u>Lexington</u> (Address)	<u>sand</u>	<u>16</u>	<u>24</u>
(2) Location: <u>SW 1/4, NW 1/4, Sec. 33 T10R3E</u>	<u>pipe clay</u>	<u>8</u>	<u>32</u>
<u>2</u> miles <u>East</u> of <u>Lexington</u> (distance) (direction) (Nearest Town)	<u>mud</u>	<u>44</u>	<u>76</u>
(3) Topography: <u>Hilly</u> (Hilly) (Flat) (Level)	<u>Mud + Sand</u>	<u>14</u>	<u>90</u>
(4) Purpose of Well: <u>Domestic</u> (Domestic Irrigation Municipal, Industrial, Other)	<u>sand</u>	<u>13</u>	<u>103</u>
	<u>mud</u>	<u>43</u>	<u>146</u>
	<u>Mud + Sand</u>	<u>9</u>	<u>155</u>
	<u>CODED</u>	<u>17</u>	<u>172</u>
	<u>mud</u>	<u>50</u>	<u>222</u>
	<u>sand</u>	<u>119</u>	<u>340</u>


Information upon completion of well:

- (1) Diameter 2 inches.
- (2) Total Depth 340 feet.
- (3) Water Level 70 feet below top of ground.
- (4) Cased to 325, Size 2.
- (5) Screen: Size 2, Length 15.
- (6) Were any formations sealed against pollution?
_____ yes, _____ no.

If YES depth of formation _____

Why _____

Drillers Remarks: _____

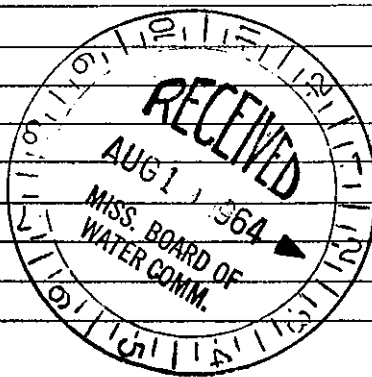

(Use Back Side)

Well No.

Mail this copy to Board of Water Commissioners 429 Miss. St. Jackson, Miss