

HOLMES  
M 17  
12-65

MISSISSIPPI BOARD OF WATER COMMISSIONERS

WATER WELL DRILLERS LOG

Date: Dec, 1965, Driller: Jack Martin County Holmes  
(Name)

CODED


|  | Description & Color of Materials<br>Sand, Clay, Red Clay, Shell, etc. | Thick-<br>ness<br>Feet | Depth<br>Feet |
|--|---|------------------------|---------------|
| (1) Owner of Land: <u>R.A. Grantham</u><br>(Name)<br><u>Lexington</u><br>(Address)   | Clay  | 24                     | 24            |
| (2) Location: <u>NE 1/4, NW 1/4, Sec. 26 T15 R3E</u><br><u>6</u> miles <u>E</u> of <u>Lexington</u><br>(distance) (direction) (Nearest Town) | Sand  | 86                     | 110           |
| (3) Topography: <u>Hilly</u><br>(Hilly) (Flat) (Level)   | Mud   | 85                     | 195           |
| (4) Purpose of Well: <u>Domestic</u><br>(Domestic Irrigation<br>Municipal, Industrial, Or <u>CODED</u> )                                     | Sand  | 65                     | 260           |

Information upon completion of well:

- (1) Diameter 2 inches.
- (2) Total Depth 260 feet.
- (3) Water Level 95 feet below top of ground.
- (4) Cased to 252, Size 2
- (5) Screen: Size 2, Length 8
- (6) Were any formations sealed against pollution?  
\_\_\_\_\_yes, \_\_\_\_\_no.

If YES depth of formation \_\_\_\_\_  
Why \_\_\_\_\_

Drillers Remarks: \_\_\_\_\_

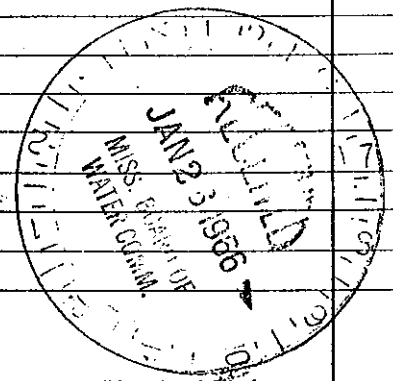

(Use Back Side)

Well No.