

Holmes
M 18
8-66

MISSISSIPPI BOARD OF WATER COMMISSIONERS

WATER WELL DRILLERS LOG CODED

Date: Aug, 1966, Driller: Jack Martin County: Holmes
(When well drilled) (Name) (Where well is located)

(1) Owner of Land: <u>Jack Martin</u> <small>(Name)</small>	Description & Color of Materials Sand, Clay, Red Clay, Shell, etc.	Thick- ness Feet	Depth Feet
<u>Lexington Route 1</u> <small>(Address)</small>	<u>Clay</u>	<u>24</u>	<u>24</u>
(2) Location: <u>NE 1/4, SE 1/4, Sec. 34 T15R3E</u>	<u>Sand</u>	<u>122</u>	<u>146</u>
<u>4</u> miles <u>E</u> of <u>Lexington</u> <small>(distance) (direction) (Nearest Town)</small>	<u>Fine Sand + mud</u>	<u>139</u>	<u>284</u>
(3) Topography: <u>Hilly</u> <small>(Hilly) (Flat) (Level)</small>	<u>Sand</u>	<u>56</u>	<u>340</u>
(4) Purpose of Well: <u>Domestic</u> <small>(Domestic Irrigation Municipal, Industrial, Other)</small>	<u>CODED</u>		

Information upon completion of well:

- (1) Diameter 2 inches.
- (2) Total Depth 340 feet.
- (3) Water Level 42 feet below top of ground.
- (4) Cased to 325, Size 2
- (5) Screen: Size 2, Length 15
- (6) Were any formations sealed against pollution?
 yes, no.

If YES depth of formation _____


Why _____

Drillers Remarks: _____

Yield in gpm: 10

Size pump: 2 H.P. Air Compressor

Type power: Electric

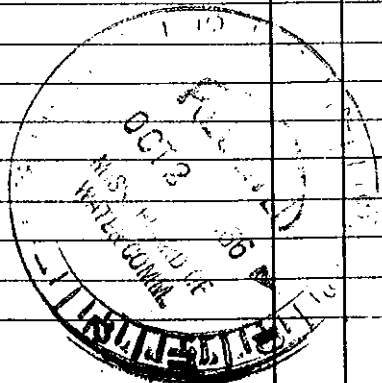

Mail this copy to Board of Water Commissioners 429 Miss. St. Jackson, Miss.