

Holmes
M 19
9-66

MISSISSIPPI BOARD OF WATER COMMISSIONERS

WATER WELL DRILLERS LOG **CODED**

Date: Sept. 1966, Driller: Jack Martin County Holmes
(When well drilled) (Name) (Where well is located)

(1) Owner of Land: <u>R.S. Richmond</u> <small>(Name)</small>	Description & Color of Materials Sand, Clay, Red Clay, Shell, etc.	Thick- ness Feet	Depth Feet
<u>Lexington - Route</u> <small>(Address)</small>	<u>Clay</u>	<u>20</u>	<u>20</u>
(2) Location: <u>NW 1/4, SW 1/4, Sec. 33 T15R3E</u>	<u>Sand</u>	<u>11</u>	<u>31</u>
<u>3</u> miles <u>E</u> of <u>Lexington</u> <small>(distance) (direction) (Nearest Town)</small>	<u>Mud</u>	<u>26</u>	<u>57</u>
(3) Topography: <u>Hilly</u> <small>(Hilly) (Flat) (Level)</small>	<u>Sand</u>	<u>13</u>	<u>70</u>
(4) Purpose of Well: <u>Domestic</u> <small>(Domestic Irrigation Municipal, Industrial, Other)</small>	CODED <u>sand + mud</u>	<u>12</u>	<u>82</u>

Information upon completion of well:	Description & Color of Materials	Thick- ness Feet	Depth Feet
(1) Diameter <u>2</u> inches.	<u>Sand</u>	<u>35</u>	<u>117</u>
(2) Total Depth <u>280</u> feet.	<u>Mud</u>	<u>26</u>	<u>143</u>
(3) Water Level <u>22</u> feet below top of ground.	<u>Fine Sand</u>	<u>73</u>	<u>216</u>
(4) Cased to <u>265</u> , Size <u>2</u>	<u>Coarse Sand</u>	<u>64</u>	<u>280</u>
(5) Screen: Size <u>2</u> , Length <u>15</u>			
(6) Were any formations sealed against pollution? <u>no</u> yes, <input checked="" type="checkbox"/> no.			

If YES depth of formation _____


Why _____

Drillers Remarks: _____

Yield in gpm: 15

Size pump: 2 H.P. Air Compressor

Type power: Electric

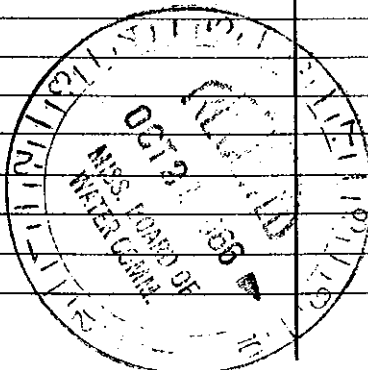

ail this copy to Board of Water Commissioners 429 Miss. St. Jackson, Miss.