

Holmes
M20
10-66

MISSISSIPPI BOARD OF WATER COMMISSIONERS

WATER WELL DRILLERS LOG

CODED


Date: Oct, 1966, Driller: Jack Martin County Holmes
(When well drilled) (Name) (Where well is located)

(1) Owner of Land: Robert Farmer
(Name)
Lexington Rd #1
(Address)
 (2) Location: SE 1/4, SE 1/4, Sec. 34 T15R3E
4 miles E of Lexington
(distance) (direction) (Nearest Town)
 (3) Topography: Hilly
(Hilly) (Flat) (Level)
 (4) Purpose of Well: Domestic
(Domestic Irrigation) (Municipal, Industrial, Other)

Description & Color of Materials Sand, Clay, Red Clay, Shell, etc.	Thick- ness Feet	Depth Feet
Clay	24	24
Sand	30	54
Mud	22	76
Sand	8	84
Mud	78	162
Mud & Sand	8	170
Sand	18	188

Information upon completion of well:

(1) Diameter 2 inches.
 (2) Total Depth 188 feet.
 (3) Water Level 36 feet below top of ground.
 (4) Cased to 179, Size 2
 (5) Screen: Size 2, Length 9
 (6) Were any formations sealed against pollution?
 _____ yes, no.
 If YES depth of formation _____
 Why _____
 Drillers Remarks: _____
 Yield in gpm: 11.9 p m
 Size pump: 3/4 HP
 Type power: Electric

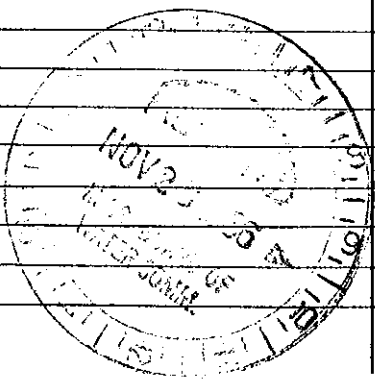

Mail this copy to Board of Water Commissioners 429 Miss. St. Jackson, Miss.