

Holmes
 M 21
 12-66

MISSISSIPPI BOARD OF WATER COMMISSIONERS

WATER WELL DRILLERS CODED

Date: Dec, 19 66, Driller: Jack Martin County Holmes
(When well drilled) (Name) (Where well is located)

(1) Owner of Land:	Description & Color of Materials Sand, Clay, Red Clay, Shell, etc.	Thick- ness Feet	Depth Feet
<u>C. W. Wherry</u> <small>(Name)</small> <u>Lexington Rt. 5, Box 74</u> <small>(Address)</small>	<u>Clay</u>	<u>20</u>	<u>20</u>
(2) Location: <u>SE 1/4, SW 1/4, Sec 23 T15 R 3E</u>	<u>Sand</u>	<u>15</u>	<u>35</u>
<u>5</u> miles <u>NE</u> of <u>Lexington</u> <small>(distance) (direction) (Nearest Town)</small>	<u>Pipe Clay Sand</u>	<u>40</u>	<u>75</u>
(3) Topography: <u>Hilly</u> <small>(Hilly) (Flat) (Level)</small>	<u>Sand</u>	<u>29</u>	<u>104</u>
(4) Purpose of Well: <u>Domestic</u> CODED <small>(Domestic Irrigation Municipal, Industrial, Other)</small>	<u>Mud</u>	<u>88</u>	<u>192</u>
	<u>Fine Sand</u>	<u>78</u>	<u>270</u>
	<u>Coarse Sand</u>	<u>22</u>	<u>292</u>

Information upon completion of well:

- (1) Diameter 2 inches.
- (2) Total Depth 292 feet.
- (3) Water Level 90 feet below top of ground.
- (4) Cased to 284, Size 2
- (5) Screen: Size 2, Length 8
- (6) Were any formations sealed against pollution?
 yes, no.

If YES depth of formation _____


Why _____

Drillers Remarks: I did not install pump

Yield in gpm: _____

Size pump: _____

Type power: _____

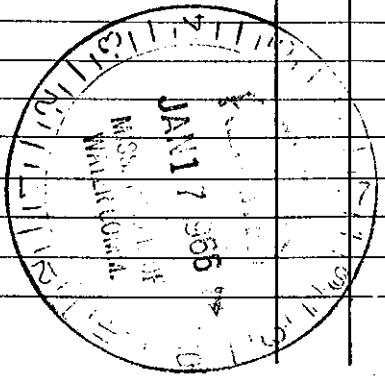

Mail this copy to Board of Water Commissioners 429 Miss. St. Jackson, Miss.