

HOLMES
N 2
2-1-62

MISSISSIPPI

WATER

WATER WELL DRILLERS LOG

0093 T

Date: Feb 1, 1962 Driller: Braswell Day Co. County Holmes

(Name)

| (1) Owner of Land | Description & Color of Materials Sand, Clay, Red Clay, Shell, etc. | Thick- ness Feet | Depth Feet |
|--|---|------------------------|---------------|
| Blanton Smith (Name) Hatchery Durant (Address) 5 14th St | Clay Sand | 21 185 | 21 126 |
| (2) Location: Location | | | |
| 2 miles NE of Durant (distance) (direction) (Nearest Town) | | | |
| (3) Topography: Hilly (Hilly) (Flat) (Level) † | | | |
| (4) Purpose of Well: Industrial (Domestic Irrigation Municipal, Industrial, Other) | | | |


Information upon completion of well:

- (1) Diameter 3 inches.
- (2) Total Depth 126 feet.
- (3) Water Level 60 feet below top of ground.
- (4) Cased to 126, Size 3
- (5) Screen: Size 2, Length 6'
- (6) Were any formations sealed against pollution?
_____ yes, _____ no.

If YES depth of formation _____

Why _____

Drillers Remarks: _____

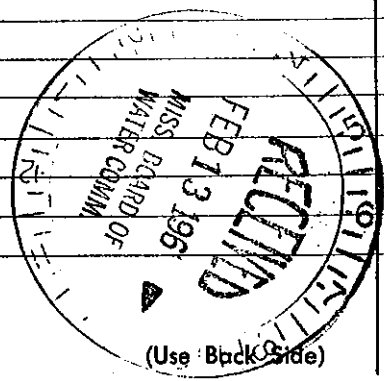

Well No.

Mail this copy to Board of Water Commissioners 429 Miss. St. Jackson, Miss.