

HOLMES MISSISSIPPI BOARD OF WATER COMMISSIONERS

N13
1-65

WATER WELL DRILLERS CODED

Date: Jan, 1965, Driller: Jack Martin County Holmes
(Name)

(1) Owner of Land:	Description & Color of Materials Sand, Clay, Red Clay, Shell, etc.	Thick- ness Feet	Depth Feet
<u>Mrs J. N. Spangler</u> (Name) <u>Durant</u> (Address)	<u>clay</u>	<u>9</u>	<u>9</u>
(2) Location: <u>SE 1/4, NE 1/4, Sec. 17 T15 R4E</u>	<u>sand</u>	<u>83</u>	<u>92</u>
<u>5</u> miles <u>N</u> of <u>Durant</u> (distance) (direction) (Nearest Town)			
(3) Topography: <u>Hilly</u> (Hilly) (Flat) (Level)			
(4) Purpose of Well: <u>Domestic</u> (Domestic Irrigation Municipal, Industrial, Other)			

CODED


Information upon completion of well:

- (1) Diameter 2 inches.
- (2) Total Depth 92 feet.
- (3) Water Level 76 feet below top of ground.
- (4) Cased to 88, Size 2
- (5) Screen: Size 2, Length 4
- (6) Were any formations sealed against pollution?
no

If YES depth of formation _____

Why _____

Drillers Remarks: _____

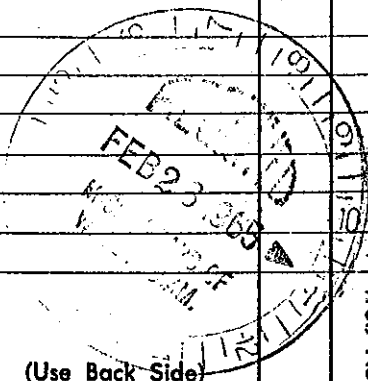

(Use Back Side)

Well No.

Mail this copy to Board of Water Commissioners 429 Miss. St. Jackson, Miss