

HOLMES MISSISSIPPI BOARD OF WATER COMMISSIONERS

N 14

1-65

WATER WELL DRILLED

CODED

Date: Jan, 19 65, Driller: Jack Martin County Holmes

(Name)

(1) Owner of Land:	Description & Color of Materials Sand, Clay, Red Clay, Shell, etc.	Thick- ness Feet	Depth Feet
Mrs. J. A. Rowland (Name) West (Address)	Clay	12	12
(2) Location: NE 1/4, SE 1/4, Sec. 23 T. 15 R. 4 E 3 1/2 miles N of Durant (distance) (direction) (Nearest Town)	Red sand	9	21
(3) Topography: Hilly (Hilly) (Flat) (Level)	Sand		120
(4) Purpose of Well: Domestic (Domestic Irrigation Municipal, Industrial, Other)	CODED		


Information upon completion of well:

- (1) Diameter 2 inches.
- (2) Total Depth 120 feet.
- (3) Water Level 100 feet below top of ground.
- (4) Cased to 115, Size 2
- (5) Screen: Size 2, Length 5
- (6) Were any formations sealed against pollution?  
 yes,  no.

If YES depth of formation \_\_\_\_\_

Why \_\_\_\_\_

Drillers Remarks: \_\_\_\_\_

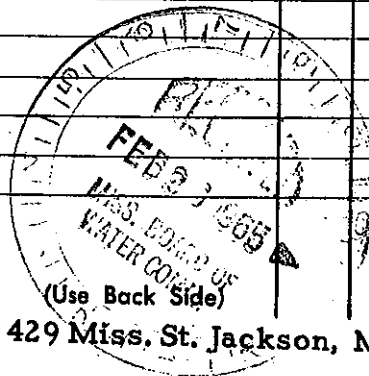

Well No.

Mail this copy to Board of Water Commissioners 429 Miss. St. Jackson, Miss