

HOLMES
N 15
3-65

MISSISSIPPI BOARD OF WATER COMMISSIONERS

WATER WELL DRILL LOG

Date: June, 1965, Driller: Jack Martin County _____
(Name)

(1) Owner of Land:	Description & Color of Materials Sand, Clay, Red Clay, Shell, etc.	Thick- ness Feet	Depth Feet
<u>A.E. McNeer</u> (Name) <u>Durant</u> (Address)	<u>Clay</u>	<u>3</u>	<u>3</u>
(2) Location: <u>NW 1/4, SW 1/4, Sec. 32 T4R1E1</u> <u>4</u> miles <u>W</u> of <u>Durant</u> (distance) (direction) (Nearest Town)	<u>Sand</u>	<u>29</u>	<u>32</u>
(3) Topography: <u>Hilly</u> (Hilly) (Flat) (Level)	<u>Mud</u>	<u>16</u>	<u>48</u>
(4) Purpose of Well: <u>Domestic</u> (Domestic Irrigation Municipal, Industrial, Other)	<u>Sand + mud</u>	<u>62</u>	<u>110</u>
	<u>Sand</u>	<u>30</u>	<u>140</u>


Information upon completion of well:

- (1) Diameter 2 inches.
- (2) Total Depth 140 feet.
- (3) Water Level 90 feet below top of ground.
- (4) Cased to 135, Size 2
- (5) Screen: Size 2, Length 5
- (6) Were any formations sealed against pollution?
_____ yes, _____ no.

If YES depth of formation _____

Why _____

Drillers Remarks: _____

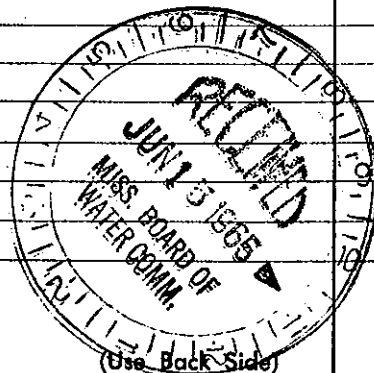

Well No. _____