

HOLMES MISSISSIPPI BOARD OF WATER COMMISSIONERS


N16  
5-13-66

WATER WELL DRILLERS LOGGED

Date: 5-13, 1966, Driller: Smith Forge & Welding County Holmes  
(Name)

	Description & Color of Materials Sand, Clay, Red Clay, Shell, etc.	Thick- ness Feet	Depth Feet
(1) Owner of Land: <u>Rosult Montgomery</u> (Name)	<u>yellow sand clay</u>	<u>15</u>	<u>15</u>
<u>R. J. Durant miss</u> (Address)	<u>yellow sand</u>	<u>12</u>	<u>27</u>
<u>Front lot 5</u>	<u>sand rock</u>	<u>12"</u>	<u>28</u>
(2) Location: <u>NW 1/4</u> , _____, Sec. <u>8</u> T <u>15</u> R <u>46</u>	<u>yellow sand</u>	<u>50</u>	<u>77</u>
<u>8</u> miles <u>NW</u> of <u>Durant</u> (distance) (direction) (Nearest Town)	<u>white san</u>		
(3) Topography: <u>Hilly</u> (Hilly) (Flat) (Level)	<u>clay mixture</u>	<u>15</u>	<u>92</u>
(4) Purpose of Well: <u>Domestic</u> (Domestic Irrigation Municipal, Industrial, Other)	<u>coarse white</u>		
	<u>sand</u>	<u>18</u>	<u>110</u>

CODED

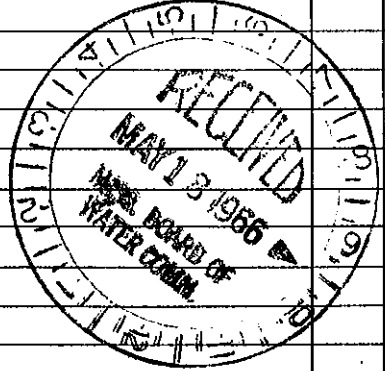

Well No. 10

(Use Back Side)

Mail this copy to Board of Water Commissioners 429 Miss. St. Jackson, Miss.