

Holmer
 N19
 7-68

MISSISSIPPI
 BOARD OF WATER COMMISSIONERS
 416 North State Street
 Jackson, Mississippi 39201

WATER WELL DRILLERS LOG

7-90-1968 Smith Forge & Welding Holmer
 date well completed firm name county well located

LANDOWNER Cottrell Holmer
 R 2 Box 32
 Durant Miss
 (mailing address)

WELL LOCATION:
 sec 7 T 15 N R 14 E
 NW 1/4 S W
 10 miles NE of Lexington
 (distance) (direction) (nearest town)


WELL PURPOSE: home
 (home, irrigation, municipal, industrial)

WELL COMPLETION DATA:

- (1) diameter (inches) 2" CODED
- (2) total depth (feet) 150
- (3) static water level (feet) 20 below above top of ground.
- (4) casing 2" galv (material) (depth) (size) If telescope see back.
- (5) screen 6" (length) (depth to top) 1/4 (size) (material)
- (6) pump 1/4 About 300 g PH (HP) (yield gpm)
Electricity (type power)
- (7) electric log NO (yes or no)
(organization running log)
- (8) how well bottom plugged

description of formations encountered

	from	to
white clay mixture	0	23
red sand	23	27
blue clay	27	31
gray sand	31	34
white clay	34	43
white sand	43	49
blue clay mixture	49	52
Char. Calc. mixture	52	55
blue clay	55	107
shell sand	107	109
gray sand mixture	109	119
gray clay	119	121
white sand	121	150

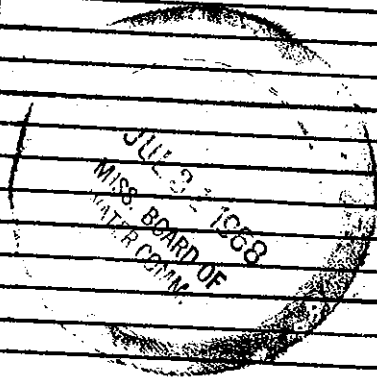

DRILLERS REMARKS: