

Holmes
03

MISSISSIPPI BOARD OF WATER COMMISSIONERS

2-67

CODED

WATER WELL DRILLERS LOG

Holmes

Date: 2-11, 1967, Driller: ^{dryer well} Megation Sev County: LeFlore
(Name)

(1) Owner of Land: Bobby Thompson
(Name)
Shartan, Miss
(Address)

(2) Location: S.W. 1/4, N.E. 1/4, Sec. 15, T14N, R2E
8 miles S.W., of Shartan
(distance) (direction) (Nearest Town)

(3) Topography: Flat
(Hilly) (Flat) (Level)

(4) Purpose of Well: Megation (Fish)
(Domestic, Irrigation, Municipal, Industrial, Other)

Description & Color of Materials Sand, Clay, Red Clay, Shell, etc.	Thick- ness Feet	Depth Feet
<u>Clay</u>	<u>43</u>	<u>43</u>
<u>Fine Sand</u>	<u>20</u>	<u>63</u>
<u>Coarse sand & gravel</u>	<u>30</u>	<u>93</u>
<u>Coarse sand & gravel</u>	<u>10</u>	<u>103</u>
<u>Well bottomed at 100 FT</u>		

CODED

Well # 2
Information upon completion of well:

(1) Diameter 16" inches.

(2) Total Depth 100 feet.

(3) Water Level 21 feet below top of ground.

(4) Cased to 60, Size 16"


(5) Screen: Size 16", Length 40'

(6) Were any formations sealed against pollution?
_____ yes, no.

If YES depth of formation _____

Why _____

Drillers Remarks: _____

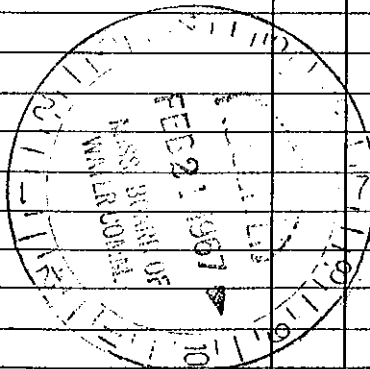

Well No:

(Use Back Side)

Mail this copy to Board of Water Commissioners 429 Miss. St. Jackson, Miss.