

HOLMES
Humphreys

MISSISSIPPI BOARD OF WATER COMMISSIONERS

2-67

WATER WELL DRILLERS LOG

HOLMES
Humphreys

Date: 2-7, 1967, Driller: IRRIGATION Ser. County LEFFLORE
(Name)

(1) Owner of Land: Bobby Thompson
(Name)
THORNTON, MISS
(Address)

(2) Location: N.E. 1/4, N.E. 1/4, Sec. 76 T14R2
7 miles SW of THORNTON
(distance) (direction) (Nearest Town)

(3) Topography: FLAT
(Hilly) (Flat) (Level)

(4) Purpose of Well: IRRIGATION (Fish)
(Domestic Irrigation
Municipal, Industrial, Other)

Description & Color of Materials Sand, Clay, Red Clay, Shell, etc.	Thick- ness Feet	Depth Feet
CLAY	33	33
FINE SAND	10	43
COARSE SAND + Gravel	60	103
COARSE SAND LARGE	10	113
ROCK		
Well Bottomed At		108'

Well #1
Information upon completion of well:

(1) Diameter 16 inches.

(2) Total Depth 108 feet.

(3) Water Level 21' feet below top of ground.

(4) Cased to 68', Size 16"


(5) Screen: Size 16", Length 40'

(6) Were any formations sealed against pollution?
yes, no.

If YES depth of formation _____

Why _____

Drillers Remarks: _____

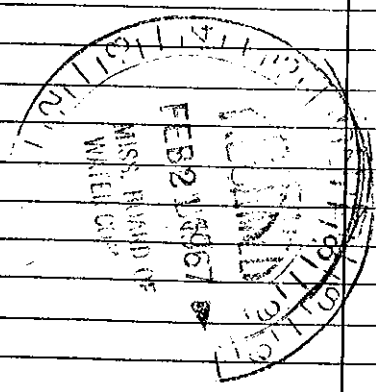

Retain this copy for your office files.

(Use Back Side)

Well No.