

State Well Report

Part 1

Mississippi Department of Environmental Quality
Office of Land and Water Resources
P.O. Box 10631
Jackson, MS 39289-0631
(601)961-5210
(601)354-6938 (fax)

County: Holmes
Permit #: GW43142
Driller: Irrigation Equipment
Date drilling completed: 4/15/09

For Office Use Only:
Aquifer: _____
Well #: Q-69
L. S. Elevation: _____
E-log #: _____

State Law requires that this report be prepared by the driller in detail and filed with the Department within 30 days of completion of drilling of the well.

Well Owner Information	Well Location
Owner Name: <u>Bailey Company</u>	Latitude: _____ Longitude: _____
Mailing Address: <u>6 Provence Blvd</u>	Method of Lat/Long (circle one): <input type="radio"/> Conventional Survey, <input type="radio"/> USGS quad, <input type="radio"/> Hand-held GPS, <input type="radio"/> Survey-grade GPS
<u>Madison</u> <u>Ms.</u> <u>39110</u>	<u>SW 1/4 SW 1/4 Sec 15</u> <u>Twn 14N</u> <u>Rng 2W</u>
City State Zip Code	Distance Direction Nearest Town <u>5</u> Miles <u>SW</u> of <u>Thornton</u>
Telephone No. () _____	

Well Data

Purpose of Well (circle one) Home Industrial Public Supply Irrigation Fish Culture Other: _____

Date well drilling started: 4/15/09 Date well drilling completed: 4/15/09

If flowing, method of flow regulation: Valve _____ Other (describe) _____

Static Water Level: 18 feet above or below (circle one) land surface Date measured: 4/15/09

Method of Measurement (circle one) steel tape electric tape air line other: _____

Hole depth: 108 Well depth: 108 Well grouted to a depth of 10 feet

Type of grout (circle one): Cement Bentonite Mix

Casing length: 68 feet Casing diameter: 16 inches Type of casing: PVC

Screen length: 40 feet Screen diameter: 16 inches Type of screen: PVC

Screen slot size: .050 inches Setting depth: From 69 feet to 108 feet

Type of completion (circle all applicable): Gravel packed Underreamed Telescoped Open hole Natural Development
Other (describe): _____

Top of lap pipe or reduction in casing: _____ feet. If telescoped or more than one screen, describe on back of page


Logs run (circle all applicable): No log run Electric Gamma Ray Density Sonic Neutron Other: _____

Name of organization running log(s): _____

I certify that the well was drilled, constructed, and completed in accordance with all applicable requirements of the Mississippi Department of Environmental Quality and/or the Mississippi Department of Health regulations and state laws.

Irrigation Equipment Inc.
John P. Chism 0439

Print Name of Water Well Contractor and License No.

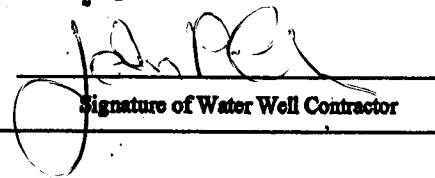
Signature of Water Well Contractor

RECEIVED

APR 24 2009

BY: OLWR

STATE WELL REPORT

Part 2

Pump Installer's Completion Report
 Mississippi Department of Environmental Quality
 Office of Land and Water Resources
 P.O. Box 10631
 Jackson, MS 39289-0631
 (601)961-5210
 (601)354-6938 (fax)

County: Holmes
 Permit #: 6W43142
 Irrigation Equipment
 Driller:
 Date completed: 4/15/09

For Office Use Only:

Aquifer:
 Well #: Q-69
 Elevation:

This report should be prepared by the pump installer in detail and filed with the Department within 30 days of the installation of pump.

Well Owner Information	Well Location
Owner Name: <u>Bailey Company</u> Mailing Address: <u>6 Provence Blvd</u> <u>Madison Ms. 39110</u> <div style="display: flex; justify-content: space-around; font-size: small;"> City State Zip Code </div> Telephone No. () _____	Latitude: _____ Longitude: _____ Method of Lat/Long (circle one): Conventional Survey, USGS quad, Hand-held GPS, Survey-grade GPS <u>SW ¼ SW ¼ Sec 15 Twn 14N Rng 2W</u> Distance Direction Nearest Town <u>5</u> Miles <u>SW</u> of <u>Thornton</u>


Pump Type Circle one	Power Type Circle one
Air Lift Jet Submersible Bucket Piston <u>Turbine</u> Centrifugal Rotary Flowing Well Other (specify): _____ Date Pump Installed: <u>4/15/09</u> Rated Pump Capacity: <u>2800 ±</u> Gallons Per Minute	<u>Diesel Engine</u> Gasoline Engine Natural Gas Electric Motor Hand Tractor PTO Windmill Other (specify): _____ Horse Power Rating of Motor: <u>60</u> Setting Depth: <u>60</u> feet Number of Stages: <u>1</u>

Pump Test Data	Method of Measuring Water Level Circle one
Date Well Tested: _____ Static Water Level (A): _____ Feet Below Land Surface Pumping Water Level (B): _____ Feet Below Land Surface Drawdown [(B) - (A)]: _____ Feet Below Land Surface Test Pumping Rate: _____ Gallons Per Minute Duration of Pump Test (minimum 4 hours): _____ hours	Air Line Electric Measuring Line Steel Tape Other (specify): _____ For flowing well, measured shut in head: _____ feet Well yielded _____ GPM with a drawdown of _____ feet after _____ hours of pumping

I HEREBY CERTIFY that the above statements are true to the best of my knowledge.

John P. Chism 0439
 Print Name of Pump Installer and License No. (if applicable) Signature of Pump Installer

RECEIVED
 APR 24 2009
 BY: OLWR

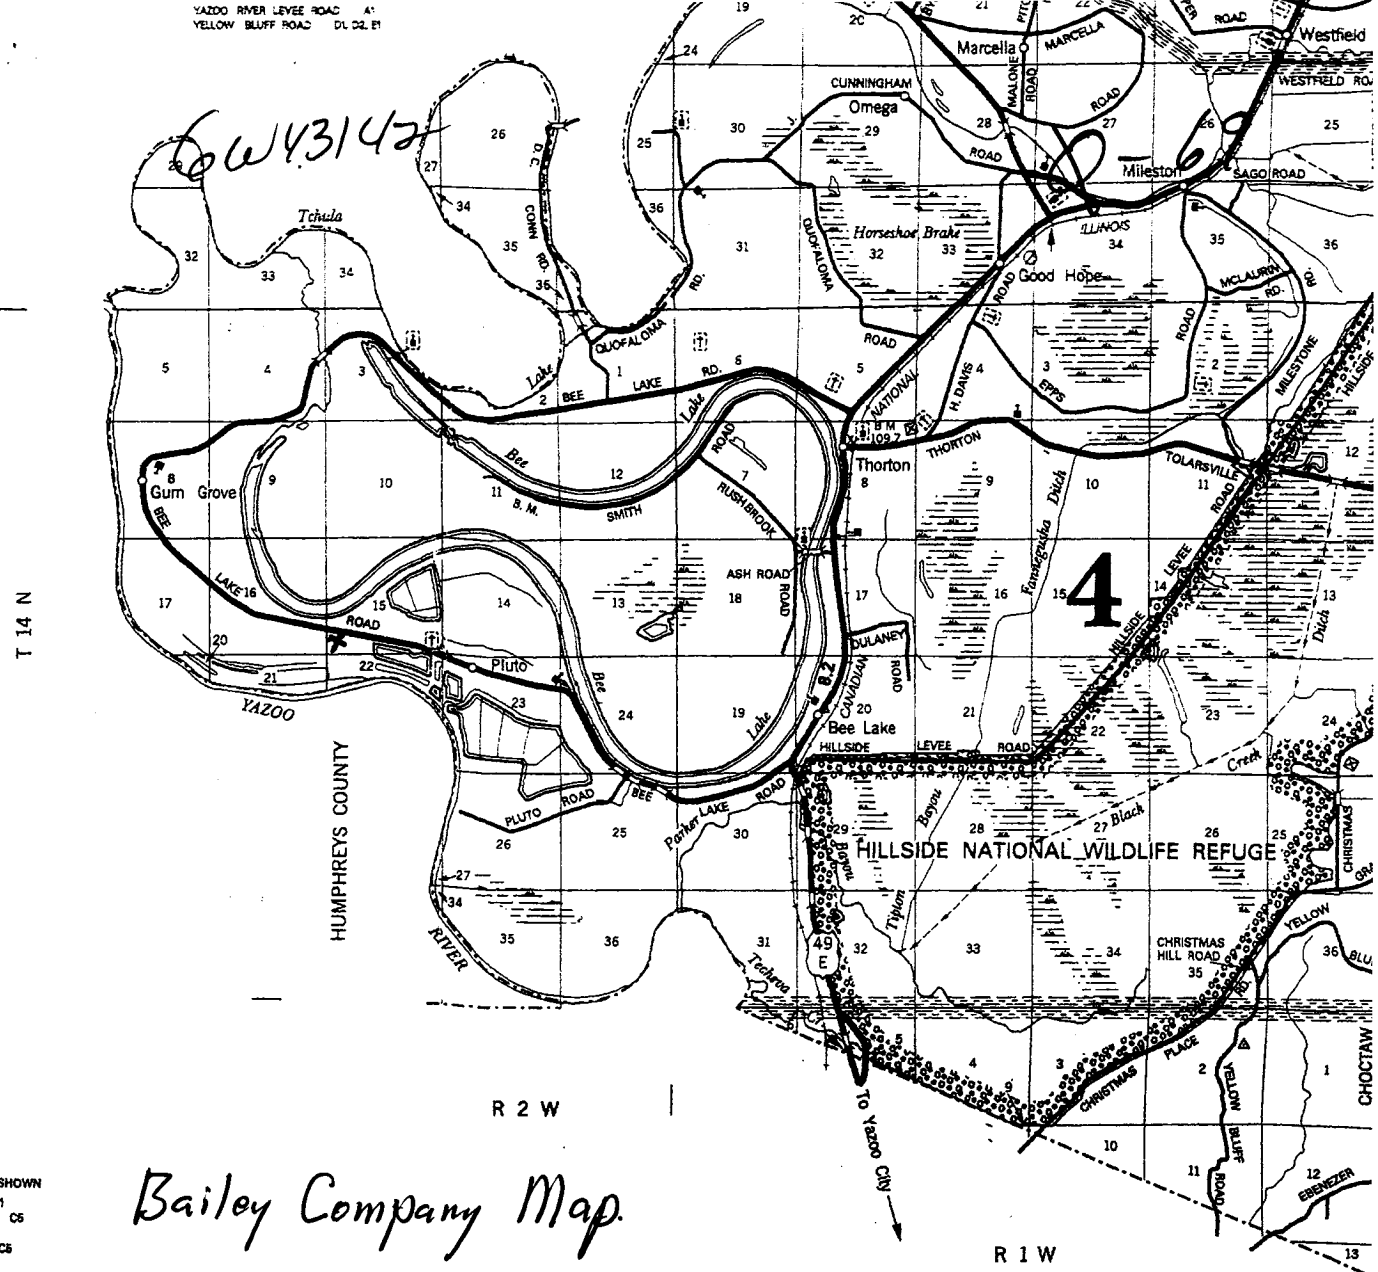

Bailey Company Map.

- STREET NAMES NOT SHOWN
1. HEAD START RD. C1
 2. OLD WHEELING RD. C5
 3. MYERS RD. B5
 4. WADE GREEN RD. C5
 5. CADE RD. B5
 6. CADE CEMETERY RD. B5
 7. MALLARD RD. B4
 8. FINCH RD. B5
 9. SWINNEY RD. C3
 10. BOULEVARD RD. C3
 11. HODGES RD. C3
 12. RATCLIFF RD. D4
 13. CROCKRELL RD. C3
 14. WEATHERS LN. D3
 15. EDWARDS ST. A5
 16. THURMOND ST. A5
 17. RICE RD. A5
 18. WILLIAMS LN. D4
 19. REDMOND LN. E3
 20. HOWARD QUARTER RD. E5
 21. ST. MARY'S CHURCH RD. E4, E5
 22. TERRY RD. E5
 23. SPENCER RD. B3
 24. OLD RACE TRACK RD. B5
 25. COUNTRY CLUB RD. INSET A
 26. McCHRISTIAN RD. C5
 27. INDUSTRIAL PARK RD. D5

MISSISSIPPI DEPARTMENT OF TRANSPORTATION
 COPYRIGHT LICENSE AGREEMENT

With the purchase of this map, the Mississippi Department of Transportation grants you the right to use the copyrighted map as set forth below.

The map is owned by the Mississippi Department of Transportation and is protected by the United States copyright laws and international provisions. You are required to treat the map like any other copyright material except that you may copy the map in whole or in part, without modification, provided the notice of copyright by the Mississippi Department of Transportation is displayed in a prominent visible location on each copy.

You have a royalty-free right to reproduce and distribute the copyrighted map in whole or in part, without modification, provided the Mississippi Department of Transportation copyright notice is displayed in a prominent visible location on each reproduction.

Any modification of a map voids this agreement and revokes your license to use, copy, and distribute the map. Use of modified maps is strictly prohibited and is subject to prosecution under State and Federal laws.

This agreement is governed by the laws of the State of Mississippi, U.S. Federal Law, and U.S. International Treaties.

Should you have any questions concerning this agreement, please write: Mississippi Department of Transportation, Planning Division, Post Office Box 1850, Jackson, Mississippi 39215-1850

RECEIVED
 APR 24 2009
 BY: OLWR