County: Holmes	-
Permit #G W - 40458 Irrigation Equipmen Driller:	t
Date drilling completed: $6-15-05$	
State Law requires that this re	-

State Well Report

Part 1

Mississippi Department of Environmental Quality
Office of Land and Water Resources
P.O. Box 10631
Jackson, MS 39289-0631
(601)961-5210
(601)354-6938 (fax)

F	or Office Use Only:
Aquifer:	O78
Well #:	J- 69
_	
L. S. Elev	vation:
E-log #:	

State Law requires that this report be prepared by the driller in detail and filed with the Department within 30 days of completion of drilling of the well

30 days of completion of drilling of the well.				
Well Owner Information	Well Location			
Owner Name Jones Planting Company	33 5 ,22.8 90 23 37.6 Latitude: Longitude: 37.6			
Mailing Address: Box 1062	Method of Lat/Long (circle one): Conventional Survey,			
	USGS quad, Hand-held GPS, Survey-orade GPS			
Yazoo City, MS 39194	SE 1/4 SW 1/4 Sec 3/103 Twn 15N Rng 1W 02W			
City State Zip Code	Distance Direction Nearest Town			
Telephone No. ()	2 Miles NW of Thornton			
Well I	Data			
Purpose of Well (circle one) Home Industrial Public Supply				
Date well drilling started: 6-15-05 Date w	well drilling completed: 6-15-05			
If flowing, method of flow regulation: Valve Other (describe)				
Static Water Level: 18 feet above or below (circle one) land surface Date measured: 6-16-05				
Method of Measurement (circle one) steel tape electric tape air line other:				
Hole depth: 125 Well depth: 125	Well grouted to a depth of feet			
Type of grout (circle one): Cement Bentonite Mix				
Casing length: 85 feet Casing diameter: 16	inches Type of casing: PVC Sch. 40			
Screen length: 40 feet Screen diameter: 16	inches Type of screen: PVC Sch. 40			
Screen slot size:inches Setting depth: From _	86 <u>feet to 125</u> feet			
Type of completion (circle all applicable): Gavel packed Under	reamed Telescoped Open hole Natural Development			
Other (describe):				
Top of lap pipe or reduction in casing:feet. If telescoped or more than one screen, describe on back of page				
Logs run (circle all applicable). No log run Electric Gamma Ray Density Sonic Neutron Other:				
Name of organization running log(s):				
I certify that the well was drilled, constructed, and completed in a	accordance with all applicable requirements of the Mississippi			
Department of Environmental Quality and/or the Mississippi Dep	partment of Health regulations and state laws.			
Irrigation Equipment Inc. Patrick M. Chism 0695	Patrick M Chin			
Print Name of Water Well Contractor and License No.	Signature of Water Well Contractor			

RECEIVED


JUL # 8 2005

Ground Level

Description of Formations Encountered	From	То
Clay	0	35
Fine Sand	36	65
Med. Sand/gravel	66	125
	<u> </u>	
		1
		1
	_	1
		1
		╀
		1
		1
	-	\vdash
	 	
		1
		+
	_	┼
		+-
		╂
	-	╁─┤
		-
	 -	1
		لـــــــــــــــــــــــــــــــــــــ

If more than one screen, show location of each on sketch

Sketch the property layout and include the following: 1) the well location; 2) any permanent structures on the property that may aid in locating the well; 3) any roads, power lines, or other items that may aid in locating the property and the well; 4) indicate direction.

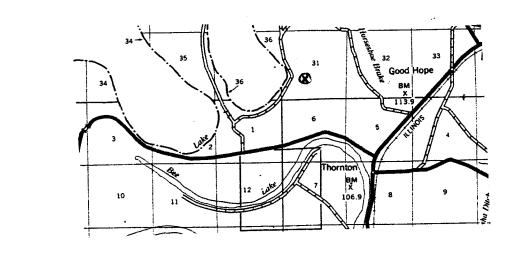

Landowner Name: _

Fatight M Chungsignature of Water Well Contractor

STATE WELL REPORT

Part 2

County: Holmes Pump Installer's Completion Report
Mississippi Department of Environmental Quality Permit#: <u>6W 4045</u> Office of Land and Water Resources Irrigation Equipment P.O. Box 10631 Jackson, MS 39289-0631 6-16-05 (601)961-5210 Date completed: (601)354-6938 (fax)

For Office Use Only:				
Aquifer:	O78			
Well #:	J-69			
Elevation:				

This report should be prepared by the pump installer in de installation of pump.	stail and filed with the Department within 30 days of the
Well Owner Information	Well Location
Owner Name: Jones Planting Company	Latitude: Longitude:
Mailing Address: Box 1062	Method of Lat/Long (circle one): Conventional Survey,
Yazoo City, MS 39194 City State Zip Code Telephone No. ()	USGS quad, Hand-held GPS, Survey-grade GPS
Pump Type Circle one	Power Type Circle one
Air Lift Jet Submersible	Diesel Engine Gasoline Engine Natural Gas
Bucket Piston Turbine	Electric Motor Hand Tractor PTO
Centrifugal Rotary Flowing Well	Windmill Other (specify):
Other (specify):	Horse Power Rating of Motor: 40
Date Pump Installed: 6-16-05	Setting Depth: 60 feet
Rated Pump Capacity: 2000 Gallons Per Minute	Number of Stages: 2
Pump Test Data	Method of Measuring Water Level Circle one
Date Well Tested: Static Water Level (A): Pumping Water Level (B): Feet Below Land Surface	Air Line Electric Measuring Line Steel Tape Other (specify):
Drawdown [(B) - (A)]:Feet Below Land Surface	For flowing well, measured shut in head: feet
Test Pumping Rate:Gallons Per Minute	Well yielded GPM with a drawdown of
Duration of Pump Test (minimum 4 hours):hours	feet afterhours of pumping
I HEREBY CERTIFY that the above statements are true to the best of Patrick M. Chism 0695 Print Name of Pump Installer and License No. (if applicable)	Tatus M Chin

RECEIVED

JUL 0 8 2005

BY: OLWA