

Holmes

MISSISSIPPI DEPARTMENT OF NATURAL RESOURCES

Bureau of Land and Water Resources

Southport Mall

P.O. Box 10631

Jackson, Mississippi 39209

WATER WELL DRILLERS LOG

TEP
Humphreys
88-158-DEP-01
J87

CODED

P165

5-31 1988
date well completed

Dyer Well
firm name

Humphreys
county well located

LANDOWNER: Stewart Wall PLT

description of formations encountered

from to

General Delivery
Thorton, Ms. 39172
(mailing address)

Clay	0	28
fine Sand	28	64
M Sand	64	72
M Sand + Gravel	72	76
Sand + Gravel	76	98
fine Sand + Gravel	98	102
Sand + Gravel	102	120

WELL LOCATION:
sec. 3 T. 14 N R. 1 W E
5 miles NW of Thorton
(distance) (direction) (nearest town)

WELL PURPOSE: Irrigation
(home, irrigation, municipal, industrial)

- WELL COMPLETION DATA:
- (1) diameter (inches) 16"
 - (2) total depth (feet) 120'
 - (3) static water level (feet) _____ below above top of ground.
 - (4) casing steel (material) _____ (depth) _____
16" (size) if telescope see back.
 - (5) screen 40' (length) _____ (depth to top) _____
16" (size) _____ (material)
 - (6) pump 60 (HP) 1250 (yield gpm)
Gear (type power)
 - (7) electric log No (yes or no)
None (organization running log)
 - (8) how well bottom plugged Plate

RECEIVED


JUN 08 1988

Department of Natural Resources
Bureau of Land & Water Resources

DRILLERS REMARKS:

If well telescopes please sketch and show depths.

GROUND LEVEL

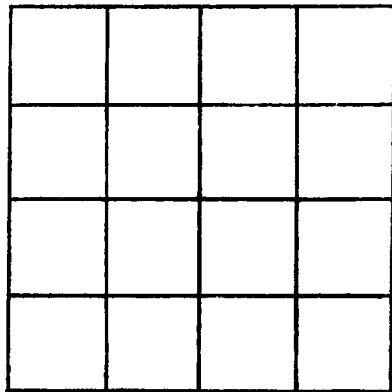

SECTION _____

Please indicate well location X.

ADDITIONAL INFORMATION

If more than one screen, show locations of each on sketch.