

STATE WELL REPORT

Part 1

Driller's Log

Mississippi Department of Environmental Quality
Office of Land and Water Resources
P.O. Box 2309
Jackson, MS 39225-2309
(601)961-5555
(601)961-5228 (fax)

For Office Use Only:

Well #: P176
Aquifer: _____
E-Log #: _____

County: Holmes

Permit #: _____

Driller: W. Bryant

Date drilling completed: 10-22-17

State Law requires that this report be prepared by the license holder responsible for the work and filed with the Department at the above address within 30 days of completion of drilling of the well or borehole.

Well Owner Information <small>(Landowner if borehole is not for a water well)</small>	Well or Borehole Location
Owner Name: <u>David L. Howard</u>	Latitude: <u>33° 05.41' N</u> Longitude: <u>90° 16.23' W</u> <small>33-05-25 90-16-14</small>
Mailing Address: <u>2632 Epps Rd.</u>	Method of Lat/Long (check one): Conventional Survey _____
<u>Tchula</u> <u>MS</u> <u>39169</u>	USGS quad _____, Hand-held GPS <input checked="" type="checkbox"/> , Survey-grade GPS _____
City State Zip Code	<u>SE 1/4 NW 1/4, Sec 2 T 14N R 1W</u>
Telephone No. <u>(662) 392-7083</u>	<u>6</u> Miles <u>N</u> of <u>Tchula, MS</u> <small>(Distance) (Direction) (Nearest Town)</small>

Well / Borehole Data

Date drilling started: 10-22-17 Date drilling completed: 10-22-17 Hole depth: 104' Hole diameter: 7"

Location of the source of any surface water used for drilling: near by ditch

Method of dosing and volume of Chlorine used in-drilling and development: Chlorine Tablets

Logs run (check all applicable): log run Electric Gamma Ray Density Sonic Neutron Other: None

Name of organization running log(s): _____

Purpose of borehole (check one): Water Well Geotechnical/Geological Investigation Ground Source Heat Pump Seismic Survey Other (describe) _____

If drilling is not related to water well construction, skip the remainder of this block

Purpose of Well (check all applicable): Home Industrial Public Supply Irrigation Fish Culture

Other (describe): _____

If a flowing well, method of flow regulation: Valve _____ Other (describe) _____

Static Water Level: 18 feet above or below land surface Date measured: 10-29-17
(check one)

Method of measurement (check one) Steel tape Electric tape Air line Other (describe): water level meter

Well depth: 104 Well grouted to a depth of: 12 feet Type of grout (check one) Neat Cement Bentonite Mix

Casing length: 84 feet Casing diameter: 4 inches Type of casing: PVC SCH 40

Screen length: 20 feet Screen diameter: 4 inches Type of screen: PVC slotted

Screen slot size: 0.13 inches Setting depth: From 84 feet to 104 feet

Type of completion (check all applicable) gravel packed Underreamed Open hole Natural Development

Other (describe): _____

Top of lap pipe or reduction in casing: 0 feet

If telescoped or more than one screen, describe on next page

RECEIVED
JAN 16 2018
BY OLWR

STATE WELL REPORT

Part 2

Pump Installer's Completion Report
 Mississippi Department of Environmental Quality
 Office of Land and Water Resources
 P.O. Box 2309
 Jackson, MS 39225-2309
 (601)961-5210
 (601) 360-0535 (fax)

For Office Use Only:

Well #: P176

Aquifer: _____

County: Holmes
 Permit #: _____
 Driller: W. Bryant
 Date completed: 10-22-17
 Copy information from block on Part 1

This part of the report must be completed by a licensed water well contractor or a licensed pump installer. A copy of Part 1 of the report must be attached and both parts filed with the Department at the above address within 30 days of well completion.

Well Owner Information	Well Location
Owner Name: <u>David L. Howard</u>	Latitude: <u>33° 05' 41" N</u> Longitude: <u>090° 16' 23" W</u>
Mailing Address: <u>2632 Epps Rd.</u>	Method of Lat/Long (check one): <input checked="" type="checkbox"/> Conventional Survey _____
City: <u>Tchula</u> State: <u>MS</u> Zip Code: <u>39169</u>	USGS quad _____, Hand-held GPS <input checked="" type="checkbox"/> , Survey-grade GPS _____
Telephone No. <u>(662) 392-7083</u>	<u>SE 1/4 NW 1/4, Sec 2 T 14N R 1 W</u>
	<u>6</u> Miles <u>N</u> of <u>Tchula MS</u> (Distance) (Direction) (Nearest Town)

Pump Type (check one)

Submersible Turbine Air Lift Centrifugal Flowing Well Jet Piston Rotary Other (describe): _____

Date Pump Installed: 10-29-17 Rated Pump Capacity: 45 Gallons Per Minute

Is This Pump (check one): New Repaired Replacement

Power Type (check one)

Electric Diesel Gasoline Natural Gas Tractor PTO Windmill Other (describe): _____

Horse Power Rating of Motor: 5 Setting Depth: 60 feet Number of Stages: 18

Pump Test Data for Non Flowing Well

Date Well Tested: 10-29-17 Duration of Pump Test (minimum 4 hours): 4 hours

Static Water Level (A): 18 Feet Below Land Surface Pumping Water Level (B): 20 Feet Below Land Surface

Drawdown [(B) - (A)]: 2 Feet Below Land Surface Test Pumping Rate: 55 Gallons Per Minute

Method of measurement (check one): Steel tape Electric tape Air line Other (describe): water level meter

Pump Test Data for Flowing Well

Measured shut in head: _____ feet.

Well yielded 55 GPM with a drawdown of 2 feet after 4 hours of pumping

Meter Installation

Meter Manufacturer: _____ Meter Serial Number: _____

Meter Model Number/Name: _____ Type of Meter: _____

Totalizer Register Unit and Multiplier Factor (AF x .001, gal x 1000, etc): _____

Installation Date: _____ Meter installed by: _____

Is This Meter (check one): New Repaired Replacement

RECEIVED
JAN 18 2018
BY OLWR


Important: By submitting the above information you are certifying that this meter was installed to manufacturer standards. For agricultural wells, a list of approved meters is on the MDEQ website.

I HEREBY CERTIFY that the above statements are true to the best of my knowledge.

Willie L. Bryant 0-639 10-29-17 Willie L. Bryant
 Print Name of Pump Installer and License No. (if applicable) Date Signature of Pump Installer

Untitled Map

Write a description for your map.

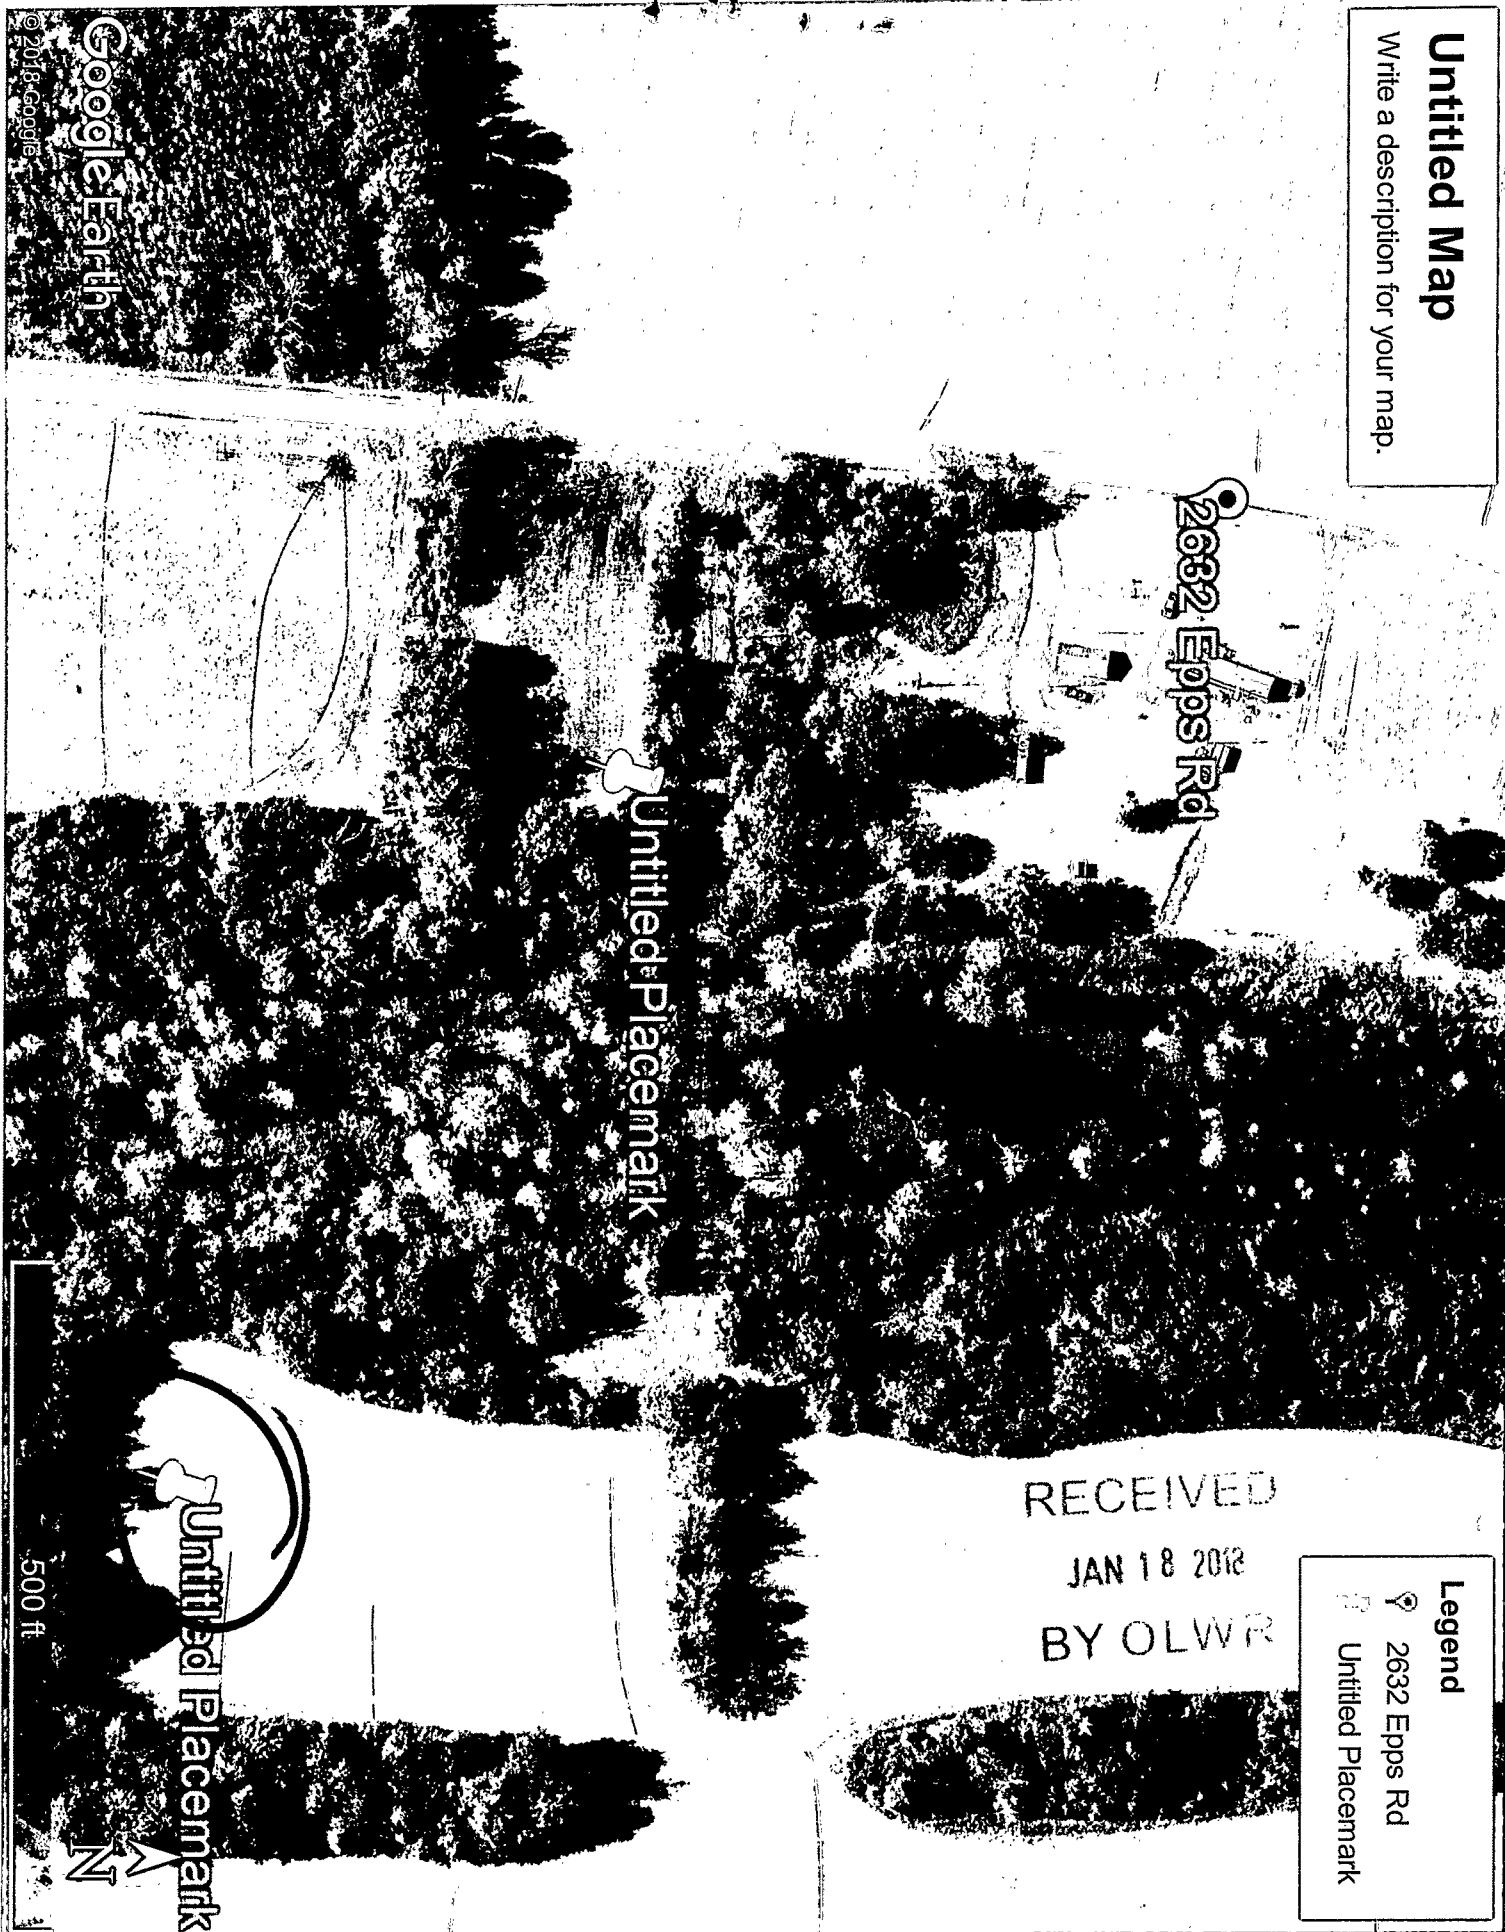

Legend

- 📍 2632 Epps Rd
- 📍 Untitled Placemark

RECEIVED
 JAN 18 2012
 BY OLWR

500 ft



© 2018 Google
Google Earth

Untitled Placemark

Untitled Placemark

2632 Epps Rd