

HOLMES

MISSISSIPPI BOARD OF WATER COMMISSIONERS

Q4


12-22-62

WATER WELL DRILLERS LOG

CODED

Date: 12/22, 1962, Driller: M. Kay County: Holmes

(1) Owner of Land:	Description & Color of Materials Sand, Clay, Red Clay, Shell, etc.	Thick- ness Feet	Depth Feet
Mrs M. McSherry (Name)	Red Clay	0	21
Lexington, Miss (Address)	Red Clay	21	42
(2) Location: 1/4, 1/4, Sec. 34 T. R.	Sandy Clay	42	63
15 miles SW of Lexington (distance, direction, Nearest Town)	Gravel-Sand	63	84
(3) Topography: (Hilly) (Flat) (Level)	Blue Clay	84	105
(4) Purpose of Well: Home (Domestic Irrigation, Municipal, Industrial, Other)	Sandy Clay	105	126
Information upon completion of well:	Sandy Clay	126	189
(1) Diameter: 2 inches.	Fine Sand	189	231
(2) Total Depth: 420 feet.	Fine Sand - Finest	231	252
(3) Water Level: 134 feet below top of ground.	Brown Clay	252	315
(4) Cased to: 105, Size: 4"	Sandy Clay	315	336
(5) Screen: Size: 006, Length: 20ft	Sandy Clay	336	357
(6) Were any formations sealed against pollution?	Fine Sand	357	378
yes, no.	3/4 H.P. Rod Pump	378	420
If YES depth of formation	CODED		
Why			
Drillers Remarks:			

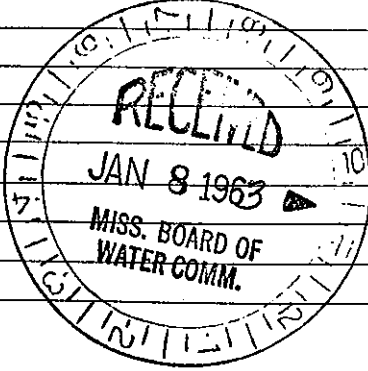

(Use Back Side)

Well No.

Mail this copy to Board of Water Commissioners 429 Miss. St. Jackson, Miss