

HOLMES

MISSISSIPPI BOARD OF WATER COMMISSIONERS

Q11
7-63


CODED

WATER WELL DRILLERS LOG

6

Date: July, 1963, Driller: Jack Martine County Holmes
(Name)

(1) Owner of Land: <u>W. W. Smith</u> (Name)	Description & Color of Materials Sand, Clay, Red Clay, Shell, etc.	Thick- ness Feet	Depth Feet
<u>Lexington</u> (Address)	<u>clay</u>	<u>19</u>	<u>19</u>
(2) Location: <u>NW 1/4, NW 1/4, Sec. 2 T4N R1E</u>	<u>clay & gravel</u>	<u>2</u>	<u>21</u>
<u>10</u> miles <u>SW</u> , of <u>Lexington</u> (distance) (direction) (Nearest Town)	<u>Red clay</u>	<u>29</u>	<u>50</u>
(3) Topography: <u>Hilly</u> (Hilly) (Flat) (Level)	<u>Blue mud</u>	<u>80</u>	<u>130</u>
(4) Purpose of Well: <u>Domestic</u> (Domestic Irrigation Municipal, Industrial, Other)	<u>Sand - mud</u>	<u>20</u>	<u>150</u>
Information upon completion of well:	<u>mud</u>	<u>8</u>	<u>158</u>
(1) Diameter <u>2</u> inches.	<u>Sand & mud</u>	<u>22</u>	<u>180</u>
(2) Total Depth <u>368</u> feet.	<u>Real fine sand</u>	<u>8</u>	<u>188</u>
(3) Water Level <u>93</u> feet below top of ground.	<u>mud</u>	<u>64</u>	<u>252</u>
(4) Cased to <u>360</u> , Size <u>2</u>	<u>fine sand</u>	<u>5</u>	<u>257</u>
(5) Screen: Size <u>2</u> , Length <u>5</u>	<u>mud</u>		<u>357</u>
(6) Were any formations sealed against pollution? _____ yes, _____ no.	<u>Rock layers sand</u>	<u>2</u>	<u>359</u>
If YES depth of formation _____	<u>Sand</u>	<u>9</u>	<u>368</u>
Why _____	<u>CODED</u>		
Drillers Remarks: _____			

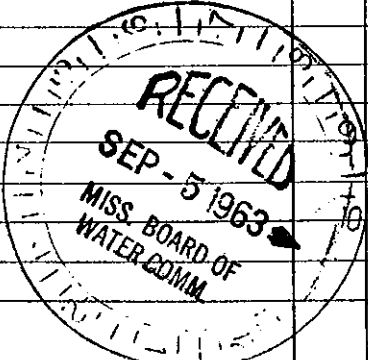

Well No.

(Use Back Side)

Mail this copy to Board of Water Commissioners 429 Miss. St. Jackson, Miss.