

HOLMES
R 4

MISSISSIPPI BOARD OF WATER COMMISSIONERS

WATER WELL DRILLERS LOG

CODED

5-30-62

Date: 5/30, 1962, Driller: Bailey Drilling Co Holmes
(Name) County Washington

(1) Owner of Land: J. A. Joe Evans
(Name)
Leffington, Miss.
(Address)

(2) Location: 33 14^N 2^E
1/4, 1/4, Sec. T. R.
6 miles South of Leffington
(distance) (direction) (Nearest Town)

(3) Topography: Hilly
(Hilly) (Flat) (Level)

(4) Purpose of Well: domestic
(Domestic Irrigation
Municipal, Industrial, Other)

Description & Color of Materials Sand, Clay, Red Clay, Shell, etc.	Thick- ness Feet	Depth Feet
Clay	123	123
Sand + mud	41	164
Sand	143	307
Sand + mud	108	415
Mud	128	543
Sand + Mud	57	600
Sand	233	833
Sand + Mud, rocks	550	1383
Sand	116	1499

Information upon completion of well:

(1) Diameter 4 X 3 X 2 1/2 X 2 inches.

(2) Total Depth 1496 feet.


(3) Water level 100 feet below top of ground.

(4) Cased to all way Size 4 X 3 X 2 1/2 X 2

(5) Screen: Size 2", Length 20ft.

(6) Were any formations sealed against pollution?
yes, X no.

CODED

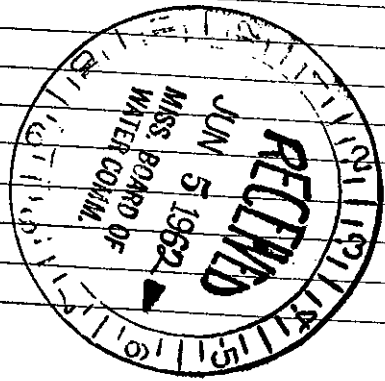

If YES depth of formation _____

Why _____

Drillers Remarks: _____

Well No.

(Use Back Side)

Mail this copy to Board of Water Commissioners 429 Miss. St. Jackson, Miss