

HOLMES Inc. info. for location

OR 5
8-1-60

WATER WELL DRILLERS LOG

CODED

Date Aug 1, 1960, Driller: M. C. Ray, County: Harrison

(Name)

(1) Owner of Land: ENOS Peltier
(Name)

Lexington Miss
(Address) 32 14 1E

(2) Location: 1/4, 1/4, Sec. 9, 18, 19, 22E
1 miles W, of Lexington
(distance) (direction) (Nearest Town)

(3) Topography: Level
(Hilly) (Flat) (Level)

(4) Purpose of Well: HOME
(Domestic Irrigation, Municipal, Industrial, Other)

Description & Color of Materials Sand, Clay, Red Clay, Shell, etc.	Thick- ness Feet	Depth Feet
no log on well		
rented 105 ft		
Repair on Well		
Heavy gravel	100-130	
SAND and gravel	130-147	

Information upon completion of well:

(1) Diameter: 2 inches.

(2) Total Depth: 147 feet.

(3) Water Level: 10 8 feet below top of ground.


(4) Cased to _____, Size _____.

(5) Screen: Size 000-0010, Length 15 ft.

(6) Were any formations sealed against pollution?
_____ yes, _____ no.

3/4 HP. JT

CODED

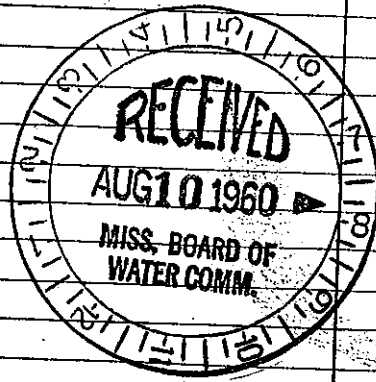

If YES depth of formation _____

Why _____

Drillers Remarks: _____

Well No.

(Use Back Side)

Retain this copy for your office files.