

HOLMES

R 7

5-17-62

MISSISSIPPI BOARD OF WATER COMMISSIONERS

WATER WELL DRILLERS LOG

CODED

Date: 5/17, 1962, Driller: M. J. Ray County, Holmes

(1) Owner of Land: S. F. Rainey (Name)

RT 1 Box 17A Lexington (Address)

(2) Location: 1/4, 1/4, Sec. 2 14 R 2 E

2 miles W of Lexington (distance) (direction) (Nearest Town)

(3) Topography: (Hilly) (Flat) (Level)

(4) Purpose of Well: Home (Domestic Irrigation Municipal, Industrial, Other)

Description & Color of Materials Sand, Clay, Red Clay, Shell, etc.

Thick-ness Feet

Depth Feet

Red Clay	0	21
Clay with Sand	21	42
Sand	42	63
Sand	63	84
Med Sand	84	105
Med Sand	105	120

Information upon completion of well:

(1) Diameter: 2 inches.

(2) Total Depth: 110 feet.

(3) Water Level: 68 feet below top of ground.

(4) Cased to: Size:

(5) Screen: Size: 008, Length: 5 ft.

(6) Were any formations sealed against pollution?

yes, no.


If YES depth of formation

Why

Drillers Remarks:

1/2 HP Rod Pump

CODED

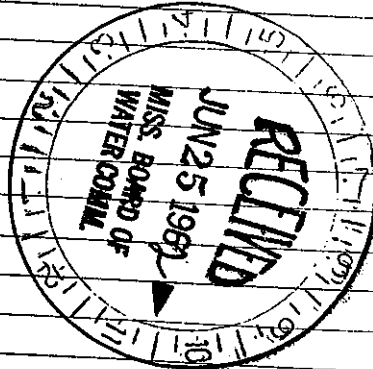

Well No.

(Use Back Side)

Mail this copy to Board of Water Commissioners 429 Miss. St. Jackson, Miss