

HOLMES
R 8

MISSISSIPPI BOARD OF WATER COMMISSIONERS

5-22-62

WATER WELL DRILLERS LOG

CODED

Date: 5/22, 1962, Driller: M. C. Kay DeLacy County Monroe
(Name)


(1) Owner of Land: <u>Bob Gufony</u> (Name)	Description & Color of Materials Sand, Clay, Red Clay, Shell, etc.	Thick- ness Feet	Depth Feet
<u>Jackson</u> <u>Miss</u> (Address)	<u>Red Clay</u>	0	21
(2) Location: $\frac{1}{4}$, $\frac{1}{4}$, Sec. <u>23</u> <u>29</u> <u>26</u> <u>T. 14</u> <u>R. 25</u>	<u>fine Sand Red</u>	21	42
<u>8</u> miles <u>S.W.</u> , of <u>Jackson</u> (distance) (direction) (Nearest Town)	<u>Red Sand</u>	42	63
(3) Topography: <input checked="" type="checkbox"/> (Hilly) <input type="checkbox"/> (Flat) <input type="checkbox"/> (Level)	<u>White Sand</u>	63	84
(4) Purpose of Well: <u>Home</u> (Domestic Irrigation Municipal, Industrial, Other)	<u>med Sand</u>	84	105
	<u>Med Sand</u>	105	126
	<u>Med Sand</u>	126	147
	<u>Med Sand</u>	147	157

Information upon completion of well:

- (1) Diameter 2 inches.
- (2) Total Depth 157 feet.
- (3) Water Level 28 feet below top of ground.
- (4) Cased to _____, Size _____
- (5) Screen: Size 008, Length 10 ft
- (6) Were any formations sealed against pollution?
_____ yes, no.

CODED

1/2 HP Red Pump

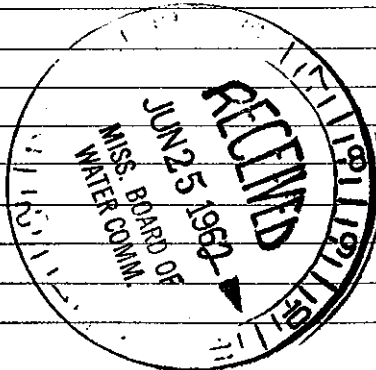

(Use Back Side)

Well No.

Mail this copy to Board of Water Commissioners 429 Miss. St. Jackson, Miss