

HOLMES MISSISSIPPI BOARD OF WATER COMMISSIONERS

R9
7-15-64

WATER WELL DRILLERS LOG

CODED

Date: 7/15, 1964, Driller: McKay County: Holmes
(Name)


(1) Owner of Land: <u>Gilroy Mrs Bob Selfer</u> (Name)	Description & Color of Materials Sand, Clay, Red Clay, Shell, etc.	Thick- ness Feet	Depth Feet
<u>Jackson Miss</u> (Address)	Red Clay	0	10
(2) Location: <u>23</u> <u>29</u> <u>26</u> T <u>42E</u> <u>6</u> miles <u>S.W.</u> of <u>Springer</u> (distance) (direction) (Nearest Town)	Sand	10	20
(3) Topography: <input checked="" type="checkbox"/> (Hilly) <input type="checkbox"/> (Flat) <input type="checkbox"/> (Level)	White Clay Sand	20	30
(4) Purpose of Well: <u>Home</u> (Domestic Irrigation Municipal, Industrial, Other)	Fine Sand	30	40
	Sand	40	60
	Fine Sand	60	80
	Med Sand	80	120
	Pink Sand	120	140

Information upon completion of well:

- (1) Diameter 2 inches.
- (2) Total Depth 140 feet.
- (3) Water Level 82 feet below top of ground.
- (4) Cased to _____, Size _____.
- (5) Screen: Size 007, Length 5.
- (6) Were any formations sealed against pollution?
_____ yes, no.

If YES depth of formation _____
Why _____
Drillers Remarks: _____

CODED

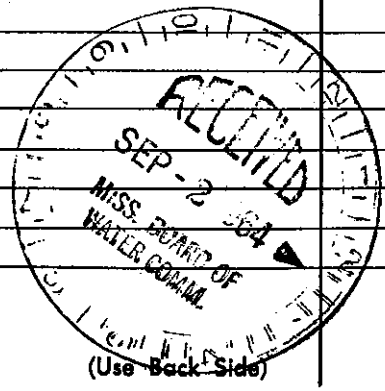

Well No.