

Holmes
 R11
 1-26-76
 E Log # 86

MISSISSIPPI
 BOARD OF WATER COMMISSIONERS CODED
 416 North State Street
 Jackson, Mississippi 39201

WATER WELL DRILLERS LOG

1-26-76 date well completed
 Robert E. Ratliff firm name
 Holmes county well located

LANDOWNER: Sweet Home
 Water Assoc. #2
 Lexington Ms.
 (mailing address)

WELL LOCATION:
 sec. ~~1~~ T 4 N R 2 E
 1 miles South of Lexington
 (distance) (direction) (nearest town)

description of formations encountered	from	to
Open Dry Sand	0	90
White Sand	90	130
Sandy Shale	130	300
Sand	300	340
Shale	340	470
White Sand	470	590
Clay	590	625
Green Sand	625	690
Shale	690	860
Sand	860	920
Shale	920	1130
Coar. Sand	1130	1170
Rock	1170	1205
Loos. Sand	1205	1255

WELL PURPOSE: Water Assoc.
 (home, irrigation, municipal, industrial)

WELL COMPLETION DATA:

(1) diameter (inches) 10 x 4

(2) total depth (feet) 1255

(3) static water level (feet) 78' below top of ground.

(4) casing steel, 1121' (depth)
 10" (size) if telescope see back.


(5) screen 50' length, 993' depth to top
 4" (size), 565' (material)

(6) pump 40 (HP), 350 (yield gpm)
 electric (type power)

(7) electric log Yes (yes or no)
 M S & S (organization running log)

(8) how well bottom plugged Back Pressure Valve

CODED

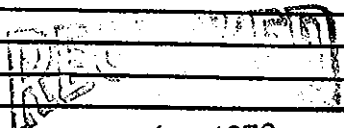

MAY 10 1976

MISS. BD. OF WATER COMM