

HOLMES

MISSISSIPPI BOARD OF WATER COMMISSIONERS

R 12

8-10-60

WATER WELL DRILLERS LOG
CODED

Date: 8-10, 1960, Driller: Jack Martin County Holmes

(Name)

(1) Owner of Land:	Description & Color of Materials	Thick-ness Feet	Depth Feet
L.C. Boatwright (Name) Lexington Miss (Address)	Red Clay	17	17
	Sand	41	58
(2) Location: SE 1/4, NW 1/4, Sec. 4 T. 12 N. R. 22 E.	Sand & Gravel	10	68
3 1/2 miles SW of Lexington (distance) (direction) (Nearest Town)	Rocks	1	69
(3) Topography: Hilly (Hilly) (Flat) (Level)	pipe clay	39	108
(4) Purpose of Well: Domestic (Domestic Irrigation Municipal, Industrial, Other)	Gravel & Sand	12	120
	Water Sand	11	131

CODED


Information upon completion of well:

- (1) Diameter 2 inches.
- (2) Total Depth 131 feet.
- (3) Water Level 82 feet below top of ground.
- (4) Cased to 126, Size 2"
- (5) Screen: Size 2", Length 5 ft
- (6) Were any formations sealed against pollution?
yes, no.

If YES depth of formation

Why

Drillers Remarks:

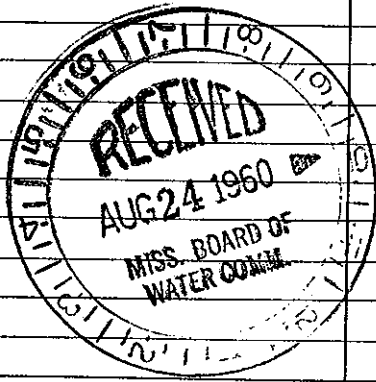

Well No.

(Use Back Side)

Mail this copy to Board of Water Commissioners 429 Miss. St. Jackson, Miss.