

HOLMES MISSISSIPPI BOARD OF WATER COMMISSIONERS

R 14
8-62

WATER WELL DRILLERS LOG CODED

Date: Aug, 1962, Driller: Jack Martin County Holmes
(Name)

(1) Owner of Land: <u>C. F. Moore</u> (Name)	Description & Color of Materials Sand, Clay, Red Clay, Shell, etc.	Thick- ness Feet	Depth Feet
<u>Lexington</u> (Address)	<u>Top clay</u>	<u>15</u>	<u>15</u>
(2) Location: <u>NE 1/4, SW 1/4, Sec. 20 T.14R2E</u>	<u>Pipe clay - little sand</u>	<u>29</u>	<u>44</u>
<u>7</u> miles <u>SW</u> of <u>Lexington</u> (distance) (direction) (Nearest Town)	<u>Mud</u>	<u>18</u>	<u>62</u>
(3) Topography: <u>Hilly</u> (Hilly) (Flat) (Level)	<u>Sand - Mud</u>	<u>39</u>	<u>101</u>
(4) Purpose of Well: <u>Domestic</u> (Domestic Irrigation Municipal, Industrial, Other)	<u>Mud</u>	<u>47</u>	<u>148</u>
	<u>Sand</u>	<u>52</u>	<u>200</u>


Information upon completion of well:

- (1) Diameter 2 inches.
- (2) Total Depth 170 feet.
- (3) Water Level 80 feet below top of ground.
- (4) Cased to 165, Size 2
- (5) Screen: Size 2", Length 5'
- (6) Were any formations sealed against pollution?
_____ yes, _____ no.

If YES depth of formation _____

Why _____

Drillers Remarks: _____

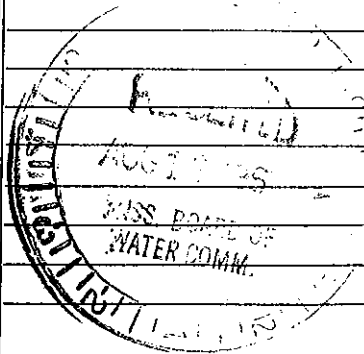

(Use Back Side)

Well No.

Mail this copy to Board of Water Commissioners 429 Miss. St. Jackson, Miss