

HOLMES MISSISSIPPI BOARD OF WATER COMMISSIONERS

R 15

1-63

WATER WELL DRILLERS LOG

Date: Jan, 19 63, Driller: CODED Jack Martin County Holmes  
 (Name)

(1) Owner of Land	Description & Color of Materials Sand, Clay, Red Clay, Shell, etc.	Thick- ness Feet	Depth Feet
<u>Mrs. S. L. Spell</u> (Name) <u>Leopoldon</u> (Address)	<u>Top. Clay</u>	<u>25</u>	<u>25</u>
(2) Location: <u>NW 1/4, NE 1/4, Sec. 31 T14R1E</u>	<u>pipe clay &amp; sand</u>	<u>80</u>	<u>105</u>
<u>7</u> miles <u>SW</u> of <u>Leopoldon</u> (distance) (direction) (Nearest Town)	<u>Sand</u>	<u>135</u>	<u>240</u>
(3) Topography: <u>Hilly</u> (Hilly) (Flat) (Level)			
(4) Purpose of Well: <u>Domestic</u> (Domestic Irrigation Municipal, Industrial, Other)			

CODED


Information upon completion of well:

- (1) Diameter 2 inches.
- (2) Total Depth 240 feet.
- (3) Water Level 96 feet below top of ground.
- (4) Cased to 225, Size 2
- (5) Screen: Size 2", Length 15'
- (6) Were any formations sealed against pollution?  
 yes,  no.

If YES depth of formation \_\_\_\_\_

Why \_\_\_\_\_

Drillers Remarks: \_\_\_\_\_

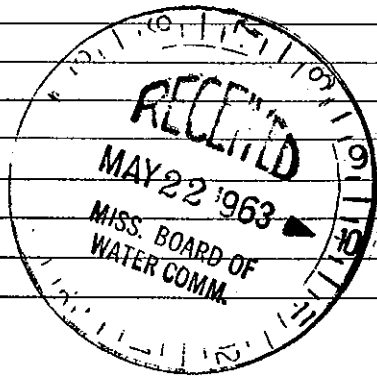

(Use Back Side)

Well No.

Mail this copy to Board of Water Commissioners 429 Miss. St. Jackson, Miss.