

HOLMES
R 16
4-63

MISSISSIPPI BOARD OF WATER COMMISSIONERS

WATER WELL DRILLERS CODED

Date: April, 1963, Driller: Jack Martin County Holmes
(Name)

(1) Owner of Land:	Description & Color of Materials Sand, Clay, Red Clay, Shell, etc.	Thick- ness Feet	Depth Feet
<u>Jesse L. Grant</u> (Name) <u>Leighton</u> (Address)	Top clay	15	15
(2) Location: <u>NW 1/4, NW 1/4, Sec. 2 T.14R2E</u> <u>2</u> miles <u>SW</u> of <u>Leighton</u> (distance) (direction) (Nearest Town)	Pipe Clay & Sand	20	35
(3) Topography: <u>Hilly</u> (Hilly) (Flat) (Level)	Sand CODED.	51	86
(4) Purpose of Well: <u>Domestic</u> (Domestic Irrigation Municipal, Industrial, Other)			


Information upon completion of well:

- (1) Diameter 2 inches.
- (2) Total Depth 86 feet.
- (3) Water Level 60 feet below top of ground.
- (4) Cased to 81, Size 2.
- (5) Screen: Size 2, Length 5.
- (6) Were any formations sealed against pollution?
_____ yes, _____ no.

If YES, depth of formation _____

Why _____

Drillers Remarks: _____

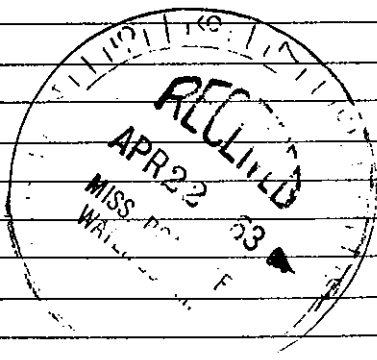

(Use Back Side)

Well No.

Mail this copy to Board of Water Commissioners 429 Miss. St. Jackson, Miss.