

HOLMES MISSISSIPPI BOARD OF WATER COMMISSIONERS

R 18  
6-63

WATER WELL DRILLERS LOG

CODED

Date: June 19 68 Driller: Jack Martin County Holmes  
(Name)

(1) Owner of Land: <u>J. H. Brooks</u> (Name)	Description & Color of Materials Sand, Clay, Red Clay, Shell, etc.	Thick- ness Feet	Depth Feet
(Address)	<u>Clay</u>	<u>26</u>	<u>26</u>
(2) Location: <u>SE 1/4, SW 1/4, Sec. 35 T14R2E</u>	<u>Pipe clay sand streak</u>	<u>22</u>	<u>48</u>
<u>8</u> miles <u>South</u> of <u>Levin</u> (distance) (direction) (Nearest Town)	<u>Fine sand</u>	<u>62</u>	<u>110</u>
(3) Topography: <u>Hilly</u> (Hilly) (Flat) (Level)	<u>sand</u>	<u>36</u>	<u>146</u>
(4) Purpose of Well: <u>domestic</u> (Domestic Irrigation Municipal, Industrial, Other)	CODED		<u>160</u>


Information upon completion of well:

- (1) Diameter 2 inches.
- (2) Total Depth 146 feet.
- (3) Water Level 86 feet below top of ground.
- (4) Cased to 141, Size 2
- (5) Screen: Size 2, Length 5
- (6) Were any formations sealed against pollution?  
\_\_\_\_\_ yes, \_\_\_\_\_ no.

If YES, depth of formation \_\_\_\_\_

Why \_\_\_\_\_

Drillers Remarks: \_\_\_\_\_

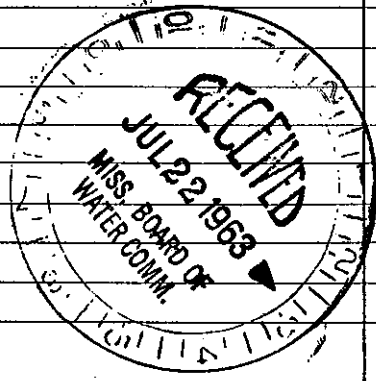

Well No.

(Use Back Side)

Mail this copy to Board of Water Commissioners 429 Miss. St. Jackson, Miss.