

HOLMES  
R 19  
7-63

MISSISSIPPI BOARD OF WATER COMMISSIONERS

CODED

WATER WELL DRILLERS LOG

Date: July, 19 63 Driller: Jack Martin County Holmes  
(Name)

(1) Owner of Land: <u>Mr Bob Boyd</u> (Name)	Description & Color of Materials Sand, Clay, Red Clay, Shell, etc.	Thick- ness Feet	Depth Feet
<u>Lexington</u> (Address)	clay	17	17
(2) Location: <u>SW 1/4, NE 1/4, Sec. 4 T4R2E</u>	sand	31	48
<u>3</u> miles <u>SW</u> of <u>Lexington</u> (distance) (direction) (Nearest Town)	CODED gravel & sand	30	78
(3) Topography: <u>Killy</u> (Hilly) (Flat) (Level)	sand	25	103
(4) Purpose of Well: <u>domestic</u> (Domestic Irrigation Municipal, Industrial, Other)	Gravel & sand	6	109


Information upon completion of well:

- (1) Diameter 2 inches.
- (2) Total Depth 124 feet.
- (3) Water Level 90 feet below top of ground.
- (4) Cased to 119, Size 2
- (5) Screen: Size 2, Length 5
- (6) Were any formations sealed against pollution?  
\_\_\_\_\_ yes, \_\_\_\_\_ no.

If YES depth of formation \_\_\_\_\_

Why \_\_\_\_\_

Drillers Remarks: \_\_\_\_\_

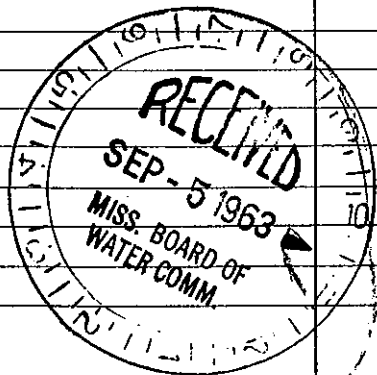

(Use Back Side)

Well No.

Mail this copy to Board of Water Commissioners 429 Miss. St. Jackson, Miss