

HOLMES MISSISSIPPI BOARD OF WATER COMMISSIONERS

R 21

5-64

WATER WELL DRILLERS LOG CODED

Date: May, 1964, Driller: Jack Martin county Holmes
(Name)

(1) Owner of Land	Description & Color of Materials Sand, Clay, Red Clay, Shell, etc.	Thick- ness Feet	Depth Feet
<u>Mrs P.W. Holley</u> (Name) <u>Lexington, Miss</u> (Address)	<u>Clay</u>	<u>24</u>	<u>24</u>
(2) Location: <u>NW 1/4, SW 1/4, Sec. 10 T4R2E</u>	<u>Pipe Clay</u>	<u>10</u>	<u>34</u>
<u>3</u> miles <u>SW</u> , of <u>Lexington</u> (distance) (direction) (Nearest town)	<u>sand & gravel</u>	<u>32</u>	<u>66</u>
(3) Topography: <u>Hilly</u> (Hilly) (Flat) (Level)	<u>Sand</u>	<u>54</u>	<u>120</u>
(4) Purpose of Well: <u>Domestic</u> (Domestic Irrigation Municipal, Industrial, Other)	<u>CODED</u>		


Information upon completion of well:

- (1) Diameter 2 inches.
- (2) Total Depth 120 feet.
- (3) Water Level 81 feet below top of ground.
- (4) Cased to 115, Size 2
- (5) Screen: Size 2, Length 5
- (6) Were any formations sealed against pollution?
_____ yes, _____ no.

If YES depth of formation _____

Why _____

Drillers Remarks: _____

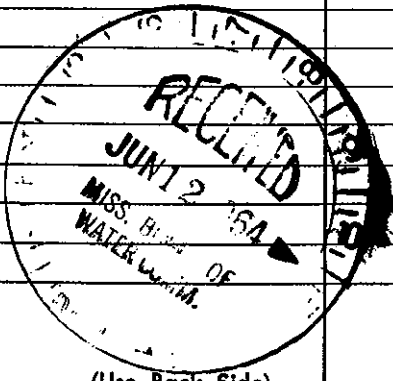

(Use Back Side)

Well No.

Mail this copy to Board of Water Commissioners 429 Miss. St. Jackson, Miss.