

HOLMES MISSISSIPPI BOARD OF WATER COMMISSIONERS

R23
1-65

WATER WELL DRILLERS LOG CODED

Date: Jan, 1965, Driller: Jack Martin County Holmes
(Name)

(1) Owner of Land: <u>L. S. Edison</u> (Name) <u>Lexington</u> (Address)	Description & Color of Materials Sand, Clay, Red Clay, Shell, etc.	Thick- ness Feet	Depth Feet
(2) Location: <u>SW 1/4, NW 1/4, Sec. 14 T14R2E</u> <u>3</u> miles <u>S</u> of <u>Lexington</u> (distance) (direction) (Nearest Town)	<u>Clay</u>	<u>21</u>	<u>21</u>
(3) Topography: <u>Hilly</u> (Hilly) (Flat) (Level)	<u>Pipe & Sand</u>	<u>20</u>	<u>41</u>
(4) Purpose of Well: <u>Domestic</u> (Domestic Irrigation Municipal, Industrial, Other)	<u>Sand</u>	<u>21</u>	<u>62</u>

CODED


Information upon completion of well:

- (1) Diameter 2 inches.
- (2) Total Depth 62 feet.
- (3) Water Level 40 feet below top of ground.
- (4) Cased to 57, Size 2
- (5) Screen: Size 2, Length 5
- (6) Were any formations sealed against pollution?
_____ yes, _____ no.

If YES depth of formation _____

Why _____

Drillers Remarks: _____

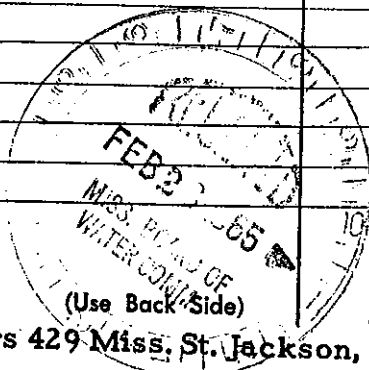

Well No. _____

Mail this copy to Board of Water Commissioners 429 Miss. St. Jackson, Miss