

HOLMES MISSISSIPPI BOARD OF WATER COMMISSIONERS


R 24

WATER WELL DRILLERS LOG CODED

1-66

Date: Jan, 1966, Driller: Jack Martin County Holmes
(Name)

(1) Owner of Land:	Description & Color of Materials Sand, Clay, Red Clay, Shell, etc.	Thick- ness Feet	Depth Feet
<u>Morrison Divins</u> (Name)	<u>Clay</u>	<u>24</u>	<u>24</u>
<u>Lexington</u> (Address)			
(2) Location: <u>1/4, SW 1/4, Sec. 18 T14R2E</u>	<u>Sand</u>	<u>41</u>	<u>65</u>
<u>7</u> miles <u>SW</u> , of <u>Lexington</u>	<u>Mud</u>	<u>53</u>	<u>118</u>
(distance) (direction) (Nearest town)			
(3) Topography: <u>Hilly</u>	<u>Sand</u>	<u>27</u>	<u>145</u>
(Hilly) (Flat) (Level)	<u>CODED</u>		
(4) Purpose of Well: <u>Domestic</u>	<u>Mud</u>	<u>35</u>	<u>180</u>
(Domestic Irrigation, Municipal, Industrial, Other)			
	<u>Mud - Sand streaks</u>	<u>70</u>	<u>250</u>
Information upon completion of well:			
(1) Diameter <u>2</u> inches.	<u>Sand</u>	<u>33</u>	<u>283</u>
(2) Total Depth <u>283</u> feet.			
(3) Water Level <u>9.5</u> feet below top of ground.			
(4) Cased to <u>273</u> , Size <u>2</u>			
(5) Screen: Size <u>2</u> , Length <u>10</u>			
(6) Were any formations sealed against pollution?			
_____ yes, _____ no.			
If YES depth of formation _____			
Why _____			
Drillers Remarks: _____			

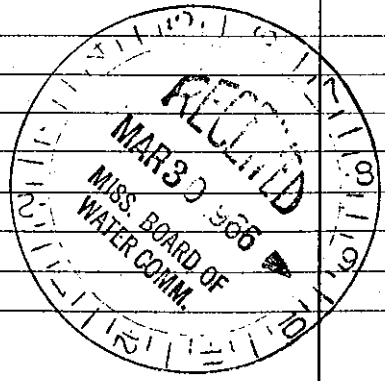

Well No.

(Use Back Side)

Mail this copy to Board of Water Commissioners 429 Miss. St. Jackson, Miss.