

Holmes
R 25
7-67

MISSISSIPPI
 BOARD OF WATER COMMISSIONERS
 416 North State Street
 Jackson, Mississippi 39201

WATER WELL DRILLERS LOG

CODED

July 1967 Jack Martin Holmes
 date well completed firm name county well located

LANDOWNER: Raymond Johnson
Lexington, Miss
Route # 2
 (mailing address)

description of formations encountered	from	to
<u>Clay</u>	<u>0</u>	<u>17</u>
<u>Redd Clay</u>	<u>17</u>	<u>39</u>
<u>Strat. Mud</u>	<u>39</u>	<u>43</u>
<u>Mud</u>	<u>43</u>	<u>93</u>
<u>Mud & Sand</u>	<u>93</u>	<u>112</u>
<u>Sand</u>	<u>112</u>	<u>194</u>

WELL LOCATION:
 sec 17 T 14 N R 2 E
6 miles SW of Lexington
 (distance) (direction) (nearest town)

CODED

WELL PURPOSE: Home
 (home, irrigation, municipal, industrial)

WELL COMPLETION DATA:

(1) diameter (inches) 2

(2) total depth (feet) 194

(3) static water level (feet) 78 below top of ground.

(4) casing galv. pipe 189
 (material) (depth)
2 If telescope see back.
 (size)


(5) screen 5 189
 (length) (depth to top)
2 Stainless Steel
 (size) (material)

(6) pump 3/4 3
 (HP) (yield gpm)
Elec
 (type power)

(7) electric log _____
 (yes or no)

 (organization running log)

(8) how well bottom plugged cap

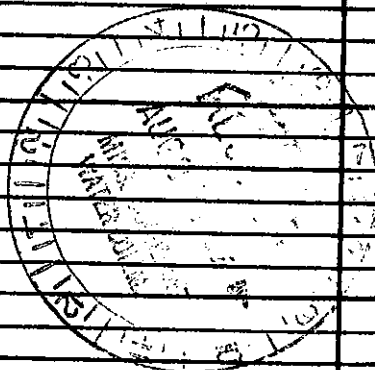

DRILLERS REMARKS: