

Holmes  
R26  
11-67

MISSISSIPPI  
BOARD OF WATER COMMISSIONERS  
416 North State Street  
Jackson, Mississippi 39201

WATER WELL DRILLERS LOG

CODED

Nov. 1967 date well completed  
Jack Martin firm name  
Holmes county well located

LANDOWNER: Mrs R.C. Causey  
Lexington  
RA # 3  
(mailing address)


description of formations encountered	from	to
Clay	0	12
pipe clay	12	21
sand	21	80

WELL LOCATION:  
sec. 15 T 14 N R 2 E  
4 miles SW of Lexington  
(distance) (direction) (nearest town)

WELL PURPOSE: home  
(home, irrigation, municipal, industrial)

- WELL COMPLETION DATA:
- (1) diameter (inches) 2
  - (2) total depth (feet) 80
  - (3) static water level (feet) 65 below top of ground.
  - (4) casing Steel, 75' (material) (depth)  
2 (size) If telescope see back.
  - (5) screen 5' 75' (length) (depth to top)  
2 (size) stainless steel (material)
  - (6) pump 1/2 (HP) 3 (yield gpm)
  - (7) electric log No (yes or no)
  - (8) how well bottom plugged Cap

CODED

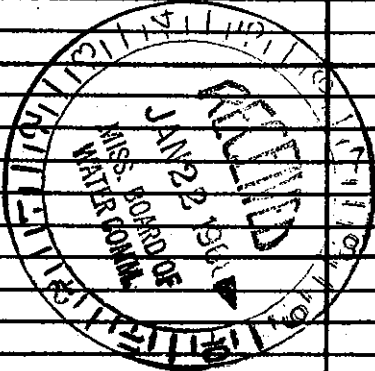

DRILLERS REMARKS: