

Holmes
R21
8-68

MISSISSIPPI
 BOARD OF WATER COMMISSIONERS
 416 North State Street
 Jackson, Mississippi 39201

WATER WELL DRILLERS LOG

Aug 19 *68* *Jack Martin* *Holmes*
 date well completed firm name county well located

LANDOWNER:
W. O. Baker
Lexington - Ark
 (mailing address)



WELL LOCATION:
 sec. *33* T. *14* N. R. *2* E.
7 miles *SW* of *Lexington*
 (distance) (direction) (nearest town)

WELL PURPOSE:
 (home, irrigation, municipal, industrial)

WELL COMPLETION DATA:

- (1) diameter (inches) 2
- (2) total depth (feet) 220
- (3) static water level (feet) 131 below above top of ground.
- (4) casing Steel, 215,
 (material) (depth)
2 If telescope see back.
 (size)
- (5) screen 5', 215
 (length) (depth to top)
2, Stainless Steel
 (size) (material)
- (6) pump 3/4, 3
 (HP) (yield gpm)
Galva
 (type power)
- (7) electric log no
 (yes or no)
 (organization running log)
- (8) how well bottom plugged Cy

description of formations encountered	from	to
<i>Clay</i>	<i>0</i>	<i>12</i>
<i>Pepe Clay</i>	<i>12</i>	<i>30</i>
<i>mud</i>	<i>30</i>	<i>198</i>
<i>Thin Rock at 129</i>		
<i>Sand</i>	<i>198</i>	<i>220</i>

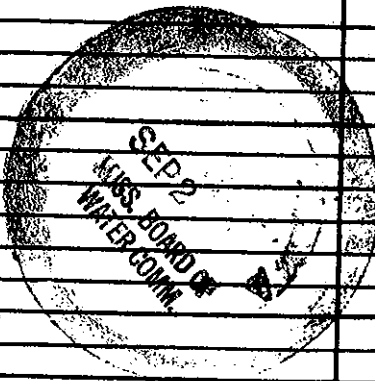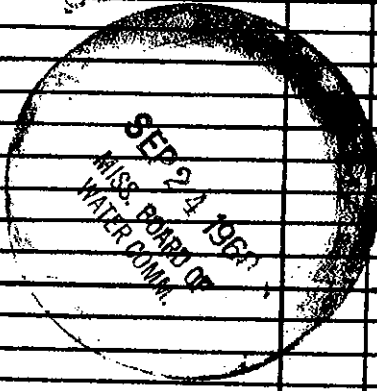

DRILLERS REMARKS: