

OF WATER COMMISSIONERS

HOLMES  
WATER WELL DRILLERS LOG

**CODED**

55

Date: June 6-63, 1963, Driller: Jack Martin County Holmes  
(Name)

(1) Owner of Land:	Description & Color of Materials Sand, Clay, Red Clay, Shell, etc.	Thick- ness Feet	Depth Feet
<u>Mr J E Ward</u> (Name) <u>Lexington</u> (Address)	<u>Clay</u>	<u>12</u>	<u>12</u>
(2) Location: <u>Drum's Well Station</u> <u>1/4, 1/4, Sec. 2 3 T 4 R 3 E</u> <u>35 36 7 38</u> <u>4 miles East of Lexington</u> (distance) (direction) (Nearest Town)	<u>Black mud</u>	<u>10</u>	<u>22</u>
(3) Topography: <u>Hilly</u> (Hilly) (Flat) (Level)	<u>Mud &amp; sand</u>	<u>36</u>	<u>58</u>
(4) Purpose of Well: <u>Domestic</u> (Domestic Irrigation Municipal, Industrial, Other)	<u>Sand</u>	<u>31</u>	<u>89</u>

Information upon completion of well:


- (1) Diameter 2 inches.
- (2) Total Depth 89 feet.
- (3) Water Level 62 feet below top of ground.
- (4) Cased to 84, Size 2
- (5) Screen: Size 2, Length 5'-10"
- (6) Were any formations sealed against pollution?  
\_\_\_\_\_ yes, \_\_\_\_\_ no.

If YES depth of formation \_\_\_\_\_

Why \_\_\_\_\_

Drillers Remarks: \_\_\_\_\_

**CODED**

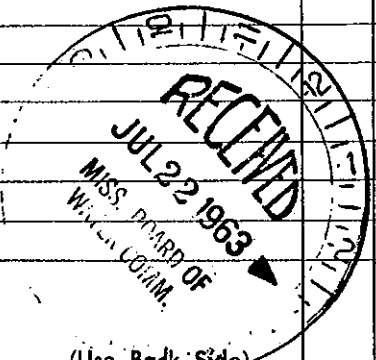

Well No. \_\_\_\_\_

Mail this copy to Board of Water Commissioners 429 Miss. St. Jackson, Miss.