

HOLMES MISSISSIPPI BOARD OF WATER COMMISSIONERS

OS6

WATER WELL DRILLERS LOG

CODED

10-19-63

Date: 10/19, 1963, Driller: M. Kay County: Holman

(1) Owner of Land: W.E. Moore
 (Name)
Lexington Miss
 (Address)

(2) Location: $\frac{1}{4}$, $\frac{1}{4}$, Sec. 20 T 18 R 3E
6 miles S of Lexington
 (distance) (direction) (Nearest Town)

(3) Topography: (Hilly) (Flat) (Level)

(4) Purpose of Well: (Domestic Irrigation)
 (Municipal, Industrial, Other)

Description & Color of Materials Sand, Clay, Red Clay, Shell, etc.	Thick- ness Feet	Depth Feet
Red clay	0	21
yellow clay	21	42
yellow clay	42	84
Sandy clay	84	147
Fine to medium sand	147	178
air pump		
CODED		

Information upon completion of well:

(1) Diameter 8 inches.

(2) Total Depth 178 feet.

(3) Water Level 88 feet below top of ground.

(4) Cased to _____, Size _____


(5) Screen: Size 007, Length 10

(6) Were any formations sealed against pollution?
 _____ yes, no.

If YES depth of formation _____

Why _____

Drillers Remarks: _____

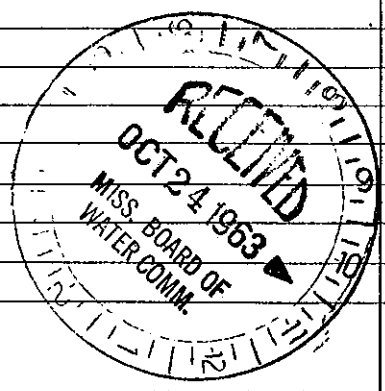

(Use Back Side)

Well No.

Mail this copy to Board of Water Commissioners 429 Miss. St. Jackson, Miss.