

HOLMES MISSISSIPPI BOARD OF WATER COMMISSIONERS

S8


WATER WELL DRILLERS LOG

CODED 300
200

12-10-60

Date: Dec 10, 1960, Driller: Jack Martin County Holmes
(Name)

(1) Owner of Land: <u>Mac W. D. Wynn</u> (Name)	Description & Color of Materials Sand, Clay, Red Clay, Shell, etc.	Thick- ness Feet	Depth Feet
<u>Pickens, Miss</u> (Address)	Red clay	18	18
(2) Location: <u>NW 1/4, NW 1/4, Sec. 28 T14R3E</u>	Sand	30	48
<u>8</u> miles <u>SE</u> of <u>Lexington</u> (distance) (direction) (Nearest Town)	Sand & pipe clay	21	69
(3) Topography: <u>Hilly</u> (Hilly) (Flat) (Level)	Sand	31	100
(4) Purpose of Well: <u>Domestic</u> (Domestic Irrigation Municipal, Industrial, Other)			

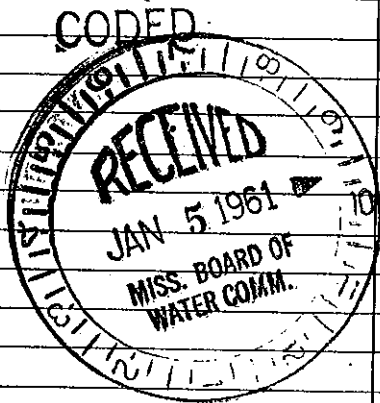

Information upon completion of well:

- (1) Diameter 2 inches.
- (2) Total Depth 99 feet.
- (3) Water Level 65 feet below top of ground.
- (4) Cased to 94, Size 2
- (5) Screen: Size 2, Length 5
- (6) Were any formations sealed against pollution?
_____ yes, no.

If YES depth of formation _____

Why _____

Drillers Remarks: _____

(Use Back Side)

Well No.

Mail this copy to Board of Water Commissioners 429 Miss. St. Jackson, Miss