

HOLMES MISSISSIPPI BOARD OF WATER COMMISSIONERS

S9
2-63

WATER WELL DRILLERS LOG CODED

Date: Feb, 19 63; Driller: Jack Martin County Holmes
(Name)

(1) Owner of Land:	Description & Color of Materials Sand, Clay, Red Clay, Shell, etc.	Thick- ness Feet	Depth Feet
Eliza Lewis (Name) Lexington (Address)	Top clay	11	11
(2) Location: SE 1/4, NW 1/4, Sec. 17, T. 14 R. 3 E.	Sand	5	16
6 miles South of Lexington (distance) (direction) (Nearest Town)	Pipe clay & sand	8	24
(3) Topography: Hilly (Hilly) (Flat) (Level)	Sand	76	100
(4) Purpose of Well: Domestic (Domestic Irrigation Municipal, Industrial, Other)	Red Sand	64	164


Information upon completion of well:

- (1) Diameter 2 inches.
- (2) Total Depth 164 feet.
- (3) Water Level 90 feet below top of ground.
- (4) Cased to 159, Size 2
- (5) Screen: Size 2, Length 5
- (6) Were any formations sealed against pollution?
_____ yes, _____ no.

If YES depth of formation _____

Why _____

Drillers Remarks: _____

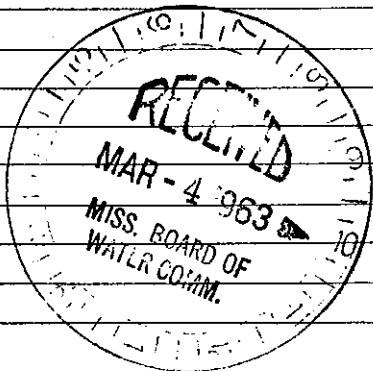

(Use Back Side)

Well No.

Mail this copy to Board of Water Commissioners 429 Miss. St. Jackson, Miss.