

HOLMES MISSISSIPPI BOARD OF WATER COMMISSIONERS

S 11
8-64

WATER WELL DRILLERS LOG

Date: Aug, 1964, Driller: Jack Martine county Halbert
(Name)

(1) Owner of Land: Joe Griffin
(Name)

(2) Location: 1/4 NW 1/4, SE 1/4, Sec. 12 T14R3E

7 miles SW of Durant
(distance) (direction) (Nearest Town)

(3) Topography: Hilly
(Hilly) (Flat) (Level)

(4) Purpose of Well:
(Domestic Irrigation
Municipal, Industrial, Other)

Description & Color of Materials Sand, Clay, Red Clay, Shell, etc.	Thick- ness Feet	Depth Feet
<u>clay</u>	<u>8</u>	<u>9</u>
<u>pipe clay</u>	<u>4</u>	<u>12</u>
<u>Sand</u>	<u>76</u>	<u>88</u>
<u>Sand (water)</u>	<u>22</u>	<u>110</u>

CODED

Information upon completion of well:

(1) Diameter 2 inches.

(2) Total Depth 110 feet.

(3) Water Level 85 feet below top of ground.

(4) Cased to 105, Size 2


(5) Screen: Size 5", Length 5'

(6) Were any formations sealed against pollution?
no

If YES depth of formation _____

Why _____

Drillers Remarks: _____

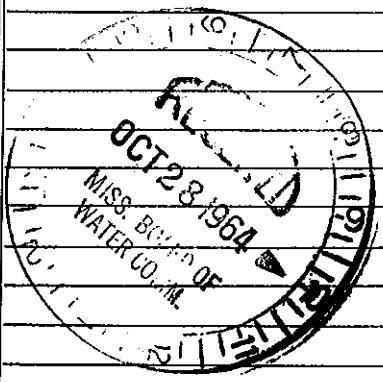

(Use Back Side)

Well No.

Mail this copy to Board of Water Commissioners 429 Miss. St. Jackson, Miss