

HOLMES MISSISSIPPI BOARD OF WATER COMMISSIONERS

S 12
2-66

WATER WELL DRILLERS LOG CODED

Date: Feb, 1966, Driller: Jack Martin County Holmes
(Name)

(1) Owner of Land: <u>M. B. Gray</u> (Name)	Description & Color of Materials Sand, Clay, Red Clay, Shell, etc.	Thick- ness Feet	Depth Feet
<u>State College</u> (Address)	Clay	14	14
(2) Location: <u>NW 1/4, NW 1/4, Sec. 2 T14R3E</u>	Sand	14	28
<u>4</u> miles <u>E</u> of <u>Lexington</u> (distance) (direction) (Nearest Town)	Sand-p. Clay	28	56
(3) Topography: <u>Hilly</u> (Hilly) (Flat) (Level)	CODED	20	76
(4) Purpose of Well: <u>Domestic</u> (Domestic Irrigation Municipal, Industrial, Other)	Sand	24	100


Information upon completion of well:

- (1) Diameter 2 inches.
- (2) Total Depth 100 feet.
- (3) Water Level 42 feet below top of ground.
- (4) Cased to 95, Size 2
- (5) Screen: Size 2, Length 5
- (6) Were any formations sealed against pollution?
_____ yes, _____ no.

If YES depth of formation _____

Why _____

Drillers Remarks: _____

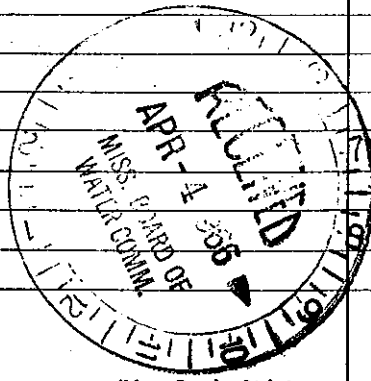

(Use Back Side)

Well No.