

HOLMES MISSISSIPPI BOARD OF WATER COMMISSIONERS

S13
4-66

WATER WELL DRILLERS LOG CODED

Date: April, 1966, Driller: Jack Martin County Holmes
(Name)

(1) Owner of Land: <u>W. J. Waits</u> (Name)	Description & Color of Materials Sand, Clay, Red Clay, Shell, etc.	Thick- ness Feet	Depth Feet
<u>Goodman</u> (Address)	<u>Clay</u>	<u>14</u>	<u>14</u>
(2) Location: <u>NW 1/4, NE 1/4, Sec. 28 T14R3E</u>	<u>F. clay</u>	<u>3</u>	<u>17</u>
<u>6</u> miles <u>N 60</u> , of <u>Goodman</u> (distance) (direction) (Nearest Town)	<u>Sand</u>	<u>4</u>	<u>21</u>
(3) Topography: <u>Hilly</u> (Hilly) (Flat) (Level)	<u>Mud</u>	<u>15</u>	<u>39</u>
(4) Purpose of Well: _____ (Domestic irrigation Municipal, Industrial, Other)	<u>Sand</u> CODED	<u>23</u>	<u>62</u>


Information upon completion of well:

- (1) Diameter 2 inches.
- (2) Total Depth 62 feet.
- (3) Water Level 22 feet below top of ground.
- (4) Cased to 57, Size 2"
- (5) Screen: Size 2", Length 5'
- (6) Were any formations sealed against pollution?
_____ yes, _____ no.

If YES depth of formation _____

Why _____

Drillers Remarks: _____

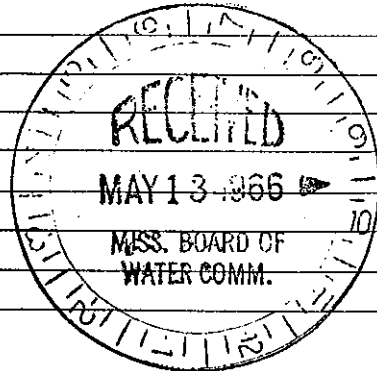

(Use Back Side)

Well No.