

HOLMES MISSISSIPPI BOARD OF WATER COMMISSIONERS


S14
5-66

WATER WELL DRILLERS LOG CODED

Date: May, 1966, Driller: Jacob Martin County Holmes
(Name)

(1) Owner of Land: <u>Loukey Pippin</u> (Name)	Description & Color of Materials Sand, Clay, Red Clay, Shell, etc.	Thick- ness Feet	Depth Feet
<u>Lawson</u> (Address)	<u>clay</u>	<u>14</u>	<u>14</u>
(2) Location: <u>NW 1/4, SW 1/4, Sec. 36 T14R3E</u>	<u>fine clay</u>	<u>4</u>	<u>18</u>
<u>1/2</u> miles <u>NW</u> , of <u>Lawson</u> (distance) (direction) (Nearest Town)	<u>sand</u>	<u>16</u>	<u>34</u>
(3) Topography: <u>Hilly</u> (Hilly) (Flat) (Level)	<u>pipe clay</u>	<u>5</u>	<u>39</u>
(4) Purpose of Well: <u>Domestic</u> (Domestic Irrigation Municipal, Industrial, Other)	<u>sand</u>	<u>23</u>	<u>62</u>
Information upon completion of well:			
(1) Diameter <u>2</u> inches.			
(2) Total Depth <u>62</u> feet.			
(3) Water Level <u>46</u> feet below top of ground.			
(4) Cased to <u>57</u> , Size <u>2</u>			
(5) Screen: Size <u>2"</u> , Length <u>5'</u>			
(6) Were any formations sealed against pollution? _____ yes, _____ no.			
If YES depth of formation _____			
Why _____			
Drillers Remarks: _____			

CODED

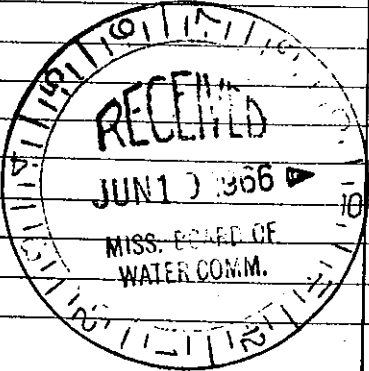

Well No.

(Use Back Side)

Mail this copy to Board of Water Commissioners 429 Miss. St. Jackson, Miss.