

Holmes  
515  
7-67

MISSISSIPPI  
 BOARD OF WATER COMMISSIONERS **CODED**  
 416 North State Street  
 Jackson, Mississippi 39201

WATER WELL DRILLERS LOG

July 1967 Josh Martin Holmes  
 date well completed firm name county well located

LANDOWNER: C. L. Sims  
Lexington, RT # 5  
 (mailing address)

description of formations encountered	from	to
<u>Clay</u>	<u>0</u>	<u>8</u>
<u>sand</u>	<u>8</u>	<u>110</u>

WELL LOCATION:  
 sec. 15 T. 14 N. R. 3 E  
5 miles SE of Lexington  
 (distance) (direction) (nearest town)

WELL PURPOSE: Home  
 (home, irrigation, municipal, industrial)

WELL COMPLETION DATA:

(1) diameter (inches) 2

(2) total depth (feet) 109

(3) static water level (feet) 65 below top of ground.

(4) casing Galv. pipe 105'  
 (material) (depth)

         if telescope see back.  
 (size)

(5) screen 4' 105'  
 (length) (depth to top)


2" Stainless Steel  
 (size) (material)

(6) pump Hand Pump  
 (type power)

(7) electric log           
 (yes or no)

          
 (organization running log)

(8) how well bottom plugged Cap

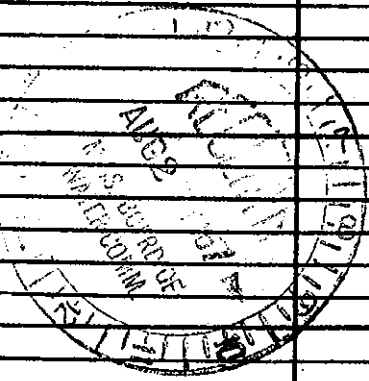

DRILLERS REMARKS: